

RAISED BY THE BERRIEN COUNTY SURVEY PEER GROUP AS THE OFFICIAL CORNER UNDER MICHIGAN PUBLIC ACT 345 OF 1990

11/29/95  
11/29/95  
11/29/95

111#2012  
111#2012  
CORNER  
STATE REVENUE FEE \$2.00

BERRIEN COUNTY REMONUMENTATION  
LAND CORNER RECORDATION CERTIFICATE  
Filing Requirement of Act 74, Mich. P.A. 1970

11-22-95  
For corners in

<u>BERRIEN</u> (County)	Located In:	Corner Code #
1. Public Land Survey Common to: T7S, R20W, A13 T7S, R21W, M13 T8S, R21W, M1	T 8S R 20W T _____ R _____ T _____ R _____ T _____ R _____	<u>A-1</u> _____ _____ _____
2. Property Controlling in Section	S _____ T _____ R _____ S _____ T _____ R _____	_____ _____
3. Miscellaneous Property in Sec.	S _____ T _____ R _____ S _____ T _____ R _____	_____ _____
4. Lot No. _____, Recorded Plat _____		
5. Private Claims _____		

RECORDED  
Nov 29 3 39 PM '95  
Register of Deeds Stamp & File Number

I, JOHN G. KAMER, in a field survey on NOVEMBER 27, 19 95, do hereby certify that under requirements of P.A. 74, Michigan P.A. of 1970, the corner points mentioned in lines 1 and 2 above were in conformance with regulations and rules therefore as required in the current manual of survey instructions of the United States Department of the Interior, Bureau of Land Management or by a decree of a Court of Law and/or that the corner points mentioned in lines 3, 4 and 5 above were in conformance with the rules of the Michigan Board of Land Surveyors or by a Decree of a Court of Law; established, re-established, monumented, re-monumented, recovered, found as expressed below:

A	B	C	D	E	F	G	H	I	J	K	L	M
2	6	5	4	3	2	1						
3												
4	7	8	9	10	11	12						
5												
6	18	17	16	15	14	13						
7												
8	19	20	21	22	23	24						
9												
10	30	29	28	27	26	25						
11												
12	31	32	33	34	35	36						
13												


NOTE: Not more than 4 corners, all in the same town and range, may be recorded on this certificate.

A. Description of original monument and accessories and/or subsequent restoration:  
(SEE BACK.)

B. Description of corner evidence found and/or method applied in restoring or reestablishing corner:  
- FOUND 1/2" REBAR 1.2' NORTH OF CENTERLINE OF KRUGER ROAD.  
- MEASURED 331'± WEST TO CENTERLINE OF GALIEN RIVER. THIS AGREES WITH DISTANCE IN 1957 DEWEY FIELD NOTES.  
- OCCUPATION NORTH AGREES WITH CORNER LOCATION.  
- ROAD HAS BEEN NEWLY RESURFACED.  
- THE ROAD MAY HAVE BEEN BUILT UP.

C. Description of monument for corner and accessories established to perpetuate locating the position of the corner:  
REMOVED 18" X 1/2" REBAR  
SET MON. BOX. SET A STANDARD 3' X 1" IRON PIPE W/BRASS PLATE IN MONUMENT BOX 1.2' N OF CENTERLINE RD.  
SET NAIL W/TAG IN GUARD POST SOUTH 17.46'  
SET NAIL W/TAG IN POWER POLE N 06° W 42.25'  
SET NAIL W/TAG IN 15" HICKORY N 73° E 51.69'  
SET NAIL W/TAG IN 18" MAPLE N 60° W 86.49'  
MEASURED 331'± TO CENTER OF GALIEN RIVER.  
PROBED AND AUGERED 2.0' - 2.5' AND DID NOT FIND ANY EVIDENCE OF A PREVIOUS CORNER/STONE/IRON.  
CORNER IS ACCEPTED AS A CAREFUL AND FAITHFUL PERPETUATION OF THE POSITION OF THIS ORIGINAL CORNER.

Signed by [Signature] date 11-29-95  
Surveyor's Michigan License No. 27449

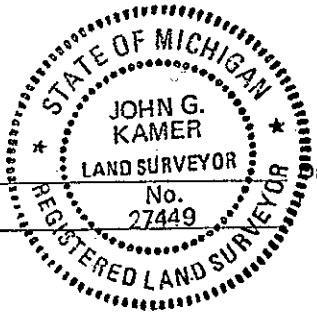

New Buffalo Township (T 8 S R 20 W)  
NW Cor. Sec. 6 (A-1)

July, 1829

Lucius Lyon, D.S.  
(From East) 80.00 Set Post Cor. to Townships  
7 & 8 South Ranges 20 & 21 West  
Ash 9 N 56 E 31  
Ash 18 N 69 W 21

Nov., 1957  
Dec., 1957

J. H. Dewey  
Found & Used Cor.  
2649.15 to E ¼ Sec. 1

April 14, 1977

Robert Beland  
LCRC Lb. 2 pg 233  
Error in Identifying Corner - Does Not Apply

Nov. 21, 1995

John G. Kamer, Wightman and Associates  
NE Cor. Sec 1-8-21  
Fnd. ½" rebar 1.2' north of centerline Kruger Road  
Set nail w/tag in guard post south 17.46'  
Set nail w/tag in power pole N 06°W 42.25'  
Set nail w/tag in 15" hickory N73°E 51.69'  
Set nail w/tag in 18" maple N60°W 86.49'  
Occupation N looked ok  
Meas. 331+/- to centerline of Galien River  
Newly resurfaced road  
road may have been built up.