

RAISED BY THE BERRIEN COUNTY SURVEY PEER GROUP AS THE OFFICIAL CORNER UNDER MICHIGAN PUBLIC ACT 345 OF 1990

09/02/94 111#2445 H33  
 09/02/94 111#2445 A33  
 CORNER \$7.00  
 STATE REMON FEE \$2.00

BERRIEN COUNTY REMONUMENTATION LAND CORNER RECORDATION CERTIFICATE  
 Filing Requirement of Act 74, Mich. P.A. 1970

*John G. Kamer*  
 4-29-94

For corners in

Berrien (County)	Located In:	Corner Code #
1. Public Land Survey	T <u>8S</u> R <u>20W</u>	B-6
	T _____ R _____	_____
	T _____ R _____	_____
	T _____ R _____	_____
2. Property Controlling in Section	S _____ T _____ R _____	_____
	S _____ T _____ R _____	_____
3. Miscellaneous Property in Sec.	S _____ T _____ R _____	_____
	S _____ T _____ R _____	_____

REGISTERED  
 SEP 2 4 21 PM 1994  
 REGISTER OF DEEDS  
 BERRIEN COUNTY - MICHIGAN  
 Register of Deeds Stamp & File Number

4. Lot No. \_\_\_\_\_, Recorded Plat \_\_\_\_\_  
 5. Private Claims \_\_\_\_\_

	A	B	C	D	E	F	G	H	I	J	K	L	M
2	6	5	4	3	2	1							
3													
4	7	8	9	10	11	12							
5													
6	17	16	15	14	13								
7													
8	19	20	21	22	23	24							
9													
10	30	29	28	27	26	25							
11													
12	31	32	33	34	35	36							
13													

I, John G. Kamer, in a field survey on August 19, 19 94, do hereby certify that under requirements of P.A. 74, Michigan P.A. of 1970, the corner points mentioned in lines 1 and 2 above were in conformance with regulations and rules therefore as required in the current manual of survey instructions of the United States Department of the Interior, Bureau of Land Management or by a decree of a Court of Law and/or that the corner points mentioned in lines 3, 4 and 5 above were in conformance with the rules of the Michigan Board of Land Surveyors or by a Decree of a Court of Law; established, re-established, monumented, re-monumented, recovered, found as expressed below:

NOTE: Not more than 4 corners, all in the same town and range, may be recorded on this certificate.

A. Description of original monument and accessories and/or subsequent restoration:

Aug. 28, 1991	V.J. Strebs - W&A	Nov. 4, 1992	John G. Kamer W&A
Oct. 29, 1991	Occupied Center of Section 18-8-20	Feb. 4, 1993	Occupied Center of Section 18-8-20
Dec. 17, 1991	(Found stone 1.43' W & 3.74' S of Intersection of 1/4 Lines)	March 22, 1993	(Found stone 1.43' W & 3.74' S of intersection of 1/4 lines)
	P.K. Nail in 12" Maple-S 20° E - 5.78'		P.K. Nail in 12" Maple-S 20°E-5.78'
	P.K. Nail in 10" Oak - N 80° E -13.04'		P.K. Nail in 10" Oak-N80°E-13.04'
	P.K. Nail in 18" Oak - N 20° E -7.38'		P.K. Nail in 18" Oak-N20°E-7.38'
	P.K. Nail in RR Tie Fence Pose -North-31.55'		P.K. Nail in RR Tie Fence Post-N-31.55'

B. Description of corner evidence found and/or method applied in restoring or reestablishing corner:


Found stone and 1991 and 1992 witness ties as shown above.

SURVEY &  
 REMONUMENTATION  
 NOV 07 1994  
 COMMISSION

C. Description of monument for corner and accessories established to perpetuate locating the position of the corner:

Set 3' Conc. Mon. w/brass plate in place of stone - The mathematical intersection of 1/4 lines is 1.43' E & 3.74' N of corner. This monument is accepted as the best available evidence of the position of the corner.  
 Set Nail w/tag in 11" Maple S40°E 5.77'  
 Set Nail w/tag in 9" Basswood N72°E 13.05'  
 Set Nail w/tag in 18" Maple N45°E 7.39'  
 Set Nail w/tag in RR Tie Fence Post North 31.54'

Signed by *John G. Kamer*  
 Surveyor's Michigan License No. 27449

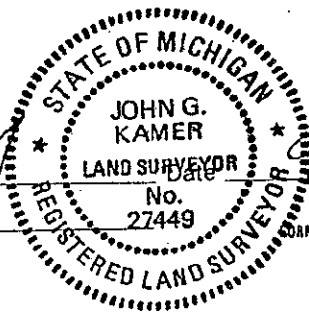

9-01-94