

RAISED BY THE BERRIEN COUNTY
 SURVEY PEER GROUP AS THE
 OFFICIAL CORNER UNDER MICHIGAN
 PUBLIC ACT 345 OF 1990
9-04-97
 For corners in

**BERRIEN COUNTY REMONUMENTATION
 LAND CORNER RECORDATION CERTIFICATE**
 Filing Requirement of Act 74, Mich. P.A. 1970


Located In: Berrien (County) Corner Code # C-3
 Located In: NE corner, Section 7, New Buffalo Township

1. Public Land Survey	T <u>8S</u> R <u>20W</u>	<u>C-3</u>
	T _____ R _____	_____
	T _____ R _____	_____
	T _____ R _____	_____
2. Property Controlling in Section	S _____ T _____ R _____	_____
	S _____ T _____ R _____	_____
3. Miscellaneous Property in Sec.	S _____ T _____ R _____	_____
	S _____ T _____ R _____	_____

12/22/97 111#6423 A99
 CORNER \$7.00
 12/22/97 111#6423 A99
 STATE REMON. FEE #2.00
 Registered or Duplicate Stamp Number

4. Lot No. _____, Recorded Plat _____
 5. Private Claims _____

I, Daniel B. Zwar, in a field survey on December 15, 1997, do hereby state that under requirements of P.A. 74, Michigan P.A. of 1970, the corner points mentioned in lines 1 and 2 above were in conformance with regulations and rules therefore as required in the current manual of survey instructions of the United States Department of the Interior, Bureau of Land Management or by a decree of a Court of Law and /or that the corner points mentioned in lines 3, 4 and 5 above were in conformance with the rules of the Michigan Board of Land Surveyors or by a Decree of a Court of Law; established, re-established, monumented, recovered, found as expressed below:

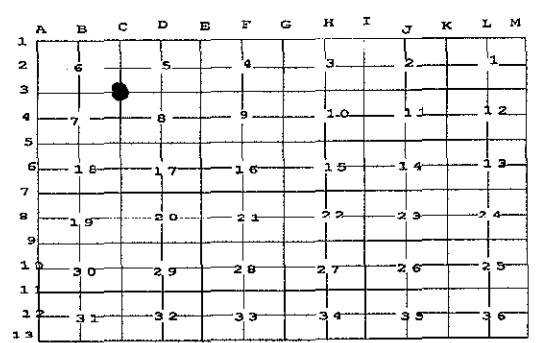

NOTE: Not more than 2 corners, all in the same town and range, may be recorded on this certificate.

A. Description of original monument and accessories and/or subsequent restoration:
 1830 - Lucius Lyon, D.S.- RAN SOUTH BETWEEN SECTIONS 5 & 6 AND SET POST CORNER - SECTIONS 5, 6, 7, & 8 - 8" BEECH N65°E - 12 LINKS: 8" SYCAMORE N58°W - 19 LINKS (BOTH GONE). BOOK 2, PAGE 377. MDOT HWY R/W BOOK SHOWS U.S.12 CENTERED ON E-W SECTION LINE.
 1982 - J.G. KAMER - RR SPIKE IN MON BOX, PK IN PP S45°E 51.18', PK IN PP N45°E 53.93', PK IN BASSWOOD CLUSTER N65W 72.73'.
 1982 - V.J. STREBS - L.C.R.C. L. 2 PAGE 421, BALL IN MON BOX, TOP CENTER OF TELEPHONE RISER, N35W 60.35', PK IN PP S45E 51.25', PK IN PP N45E 53.95'.
 1985 - J.G. KAMER - PIPE IN MON BOX, PP (NAIL IN) N35E 53.90', PP (NAIL IN) S30°E 51.24, TEL. RISER N45W 60.51.
 SEPT. 4, 1997 - RAILROAD SPIKE IN MON BOX 2' N OR U.S.12 PVMT (CONC)
 POLES APPEAR TO BE CORRECT.

B. Description of corner evidence found and/or method applied in restoring or reestablishing corner:
 FOUND RAILROAD SPIKE IN MONUMENT BOX AT INTERSECTION OF U.S.12 AND LAKESIDE ROAD. STRADDLED AND REMOVED SPIKE. DUG DOWN THROUGH BOX AN FOUND NO OTHER EVIDENCE.

C. Description of monument for corner and accessories established to perpetuate locating the position of the corner:
 PLACED STANDARD 36" X 1" IRON PIPE WITH B.C.R.P. BRASS CAP AT LOCATION OF RAILROAD SPIKE. THIS LOCATION IS ACCEPTED AS THE BEST AVAILABLE EVIDENCE OF THE POSITION OF THE ORIGINAL CORNER. MARKED EXACT SPOT ON BRASS CAP WITH A CROSS. WITNESSES: NAIL WITH TAG IN P.P. #B607-19 N40E 53.80'; NAIL WITH TAG IN P.P. #B636 S25°E 51.08'; NAIL WITH TAG IN 8" OAK N40°W 68.13" TEL. PED. N30°W 60.40'.

**SURVEY &
 REMONUMENTATION**

MAR 06 1998

SECTION

Signed by Daniel B. Zwar

Date Dec 18, 1997

Surveyor's Michigan License No. 28435

