

RAISED BY THE BERRIEN COUNTY SURVEY PEER GROUP AS THE OFFICIAL CORNER UNDER MICHIGAN PUBLIC ACT 345 OF 1990

09/02/94
09/02/94

111#2445
CORNER 111#2445
STATE REMON FEE \$2.00

John G. Kamer
8-13-94

BERRIEN COUNTY REMONUMENTATION LAND CORNER RECORDATION CERTIFICATE
Filing Requirement of Act 74, Mich. P.A. 1970

RECORDED
SEP 2 4 21 PM '94
REGISTER OF DEEDS
BERRIEN COUNTY MICHIGAN

Berrien (County)	Located In:	Corner Code #
1. Public Land Survey	T <u>8S</u> R <u>20W</u>	<u>C-6</u>
	T _____ R _____	_____
	T _____ R _____	_____
	T _____ R _____	_____
2. Property Controlling in Section	S _____ T _____ R _____	_____
	S _____ T _____ R _____	_____
3. Miscellaneous Property in Sec.	S _____ T _____ R _____	_____
	S _____ T _____ R _____	_____

Register of Deeds Stamp & File Number

- 4. Lot No. _____, Recorded Plat _____
- 5. Private Claims _____

	A	B	C	D	E	F	G	H	I	J	K	L	M
2	6		5		4		3		2		1		
3													
4	7		8		9		10		11		12		
5													
6	18		17		16		15		14		13		
7													
8	19		20		21		22		23		24		
9													
10	30		29		28		27		26		25		
11													
12	31		32		33		34		35		36		
13													

I, John G. Kamer, in a field survey on August 24, 19 94, do hereby certify that under requirements of P.A. 74, Michigan P.A. of 1970, the corner points mentioned in lines 1 and 2 above were in conformance with regulations and rules therefore as required in the current manual of survey instructions of the United States Department of the Interior, Bureau of Land Management or by a decree of a Court of Law and/or that the corner points mentioned in lines 3, 4 and 5 above were in conformance with the rules of the Michigan Board of Land Surveyors or by a Decree of a Court of Law; established, re-established, monumented, re-monumented, recovered, found as expressed below:

NOTE: Not more than 4 corners, all in the same town and range, may be recorded on this certificate.

A. Description of original monument and accessories and/or subsequent restoration:

See back.

B. Description of corner evidence found and/or method applied in restoring or reestablishing corner:


Found spike over old P.K. nail and witness ties as shown on back and agree with witnesses shown below.

SURVEY & REMONUMENTATION
NOV 07 1994
COMMISSION

C. Description of monument for corner and accessories established to perpetuate locating the position of the corner:

- Set standard 3'x1" pipe w/brass plate in place of found RR spike and 2" PK nail beneath bit. by the RR spike. Corner is accepted as a careful and faithful perpetuation of the original corner.
- Set Nail w/tag 20" Maple S42°W 35.38'
- Set Nail w/tag 11" Maple S54°E 38.06'
- Set Nail w/tag 14" Walnut N80°E 27.28'
- Set Nail w/tag 16" Walnut N51°E 33.07'

Signed by *John G. Kamer*
Surveyor's Michigan License No. 27449

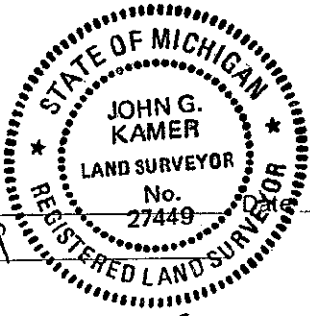

9-01-94

1830

Lucius Lyon
17 & 18-8-20
Ash S 60 E 10
Beech 17 N 43 W 13

Oct. 29, 1991

V.J. Strebs (W & A)
East 1/4 Corner
Section 18-8-20
(Fnd. R.R. Spike 2' W.
of C/L)
P.K. Nail in Power Pole - N 30° W - 94.60'
P.K. Nail in 14" Elm - N 80° E - 27.28'
P.K. Nail in 14" Elm - N 70° E - 33.04'
P.K. Nail in 20" Maple - S 50° W - 35.40'

Feb. 4, 1993

Kamer
East 1/4 Cor. 18-8-20
Found R.R. Spike
PK in PP N 30° W 94.60'
PK in 14" Elm N 80° E 27.28'
PK in 14" Elm N 70° E 33.04'
PK in 20" Maple S 50° W 35.40'

March 22, 1993

Kamer
Same as above

SURVEY &
REMONUMENTATION

NOV 07 1994

COMMISSION

LIBER 3 PAGE 136