

RAISED BY THE BERRIEN COUNTY SURVEY PEER GROUP AS THE OFFICIAL CORNER UNDER MICHIGAN PUBLIC ACT 345 OF 1990
Wasson
8-18-94

09/02/94 111#2445 A33
 CORNER \$9.00
 09/02/94 111#2445 A33
 STATE REMON FEE \$2.00

BERRIEN COUNTY REMONUMENTATION
 LAND CORNER RECORDATION CERTIFICATE
 Filing Requirement of Act 74, Mich. P.A. 1970

REGISTER OF DEEDS
 BERRIEN COUNTY MICHIGAN
 SEP 2 4 21 PM '94
 RECORDED

Register of Deeds Stamp & File Number

For corners in	<u>Berrien</u> (County)	Located In:	Corner Code #
1. Public Land Survey	T <u>8S</u> R <u>20W</u>		<u>C-7</u>
	T _____ R _____		_____
	T _____ R _____		_____
	T _____ R _____		_____
2. Property Controlling in Section	S _____ T _____ R _____		_____
	S _____ T _____ R _____		_____
3. Miscellaneous Property in Sec.	S _____ T _____ R _____		_____
	S _____ T _____ R _____		_____

4. Lot No. _____, Recorded Plat _____
 5. Private Claims _____

	A	B	C	D	E	F	G	H	I	J	K	L	M
2	6		5		4		3		2				
3													
4	7		8		9		10		11		12		
5													
6	18		17		16		15		14		13		
7													
8	19		20		21		22		23		24		
9													
10	30		29		28		27		26		25		
11													
12	31		32		33		34		35		36		
13													

I, John G. Kamer, in a field survey on August 24, 19 94, do hereby certify that under requirements of P.A. 74, Michigan P.A. of 1970, the corner points mentioned in lines 1 and 2 above were in conformance with regulations and rules therefore as required in the current manual of survey instructions of the United States Department of the Interior, Bureau of Land Management or by a decree of a Court of Law and/or that the corner points mentioned in lines 3, 4 and 5 above were in conformance with the rules of the Michigan Board of Land Surveyors or by a Decree of a Court of Law; established, re-established, monumented, re-monumented, recovered, found as expressed below:

NOTE: Not more than 4 corners, all in the same town and range, may be recorded on this certificate.


A. Description of original monument and accessories and/or subsequent restoration:
 (See Back)

B. Description of corner evidence found and/or method applied in restoring or reestablishing corner:
 Found plug as shown in previous ties.

SURVEY &
 REMONUMENTATION
 NOV 07 1994
 COMMISSION

C. Description of monument for corner and accessories established to perpetuate locating the position of the corner:
 Set standard 3' pipe w/brass plate in set mon box in place of found plug.
 Corner is accepted as a careful and faithful perpetuation of the original corner.
 Set nail w/tag in PP S40E 44.66
 Set nail w/tag 4" Hawthorne cluster S24E 57.22
 Set nail w/tag 7" Hawthorne cluster S50E 24.56
 Set nail w/tag 9" pine N26E 50.97

Signed by John G. Kamer
 Surveyor's Michigan License No. 27449

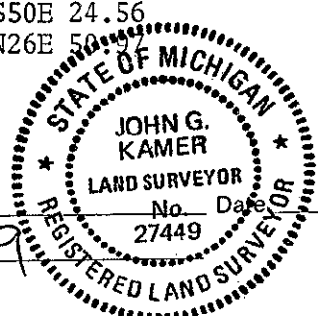

9-01-94

1830

Lucius Lyon
17, 18, 19, & 20-8-20
Beech 3 N 15 W 7
Ash 8 S 56 E 13

1945

Dewey
Tel. Pole N 45° W 54.9'
End Guard Post N 70° W 84.6'
End Guard Post S 20° E 41.5'
Twin Willow N 40° E 40.4'

1948, 1954, 1960

BCRC
Same as above

1978

BCRC
Plug
24" Willow S 75° E 23.94' (Plug)
18" Willow N 53° E 44.9'
3" Spruce N 52° E 24.6'
3" Pine N 37° E 36.4'
Stop Sign N 45° W 44.0'
Nail in Top Guard Post S 40° W 97.57'
Nail in Top Guard Post S 52° W 98.31'
Nail in Side Guard Post S 15° E 51.34'

July 19, 1990

Kamer W & A Drwg. C-1671
Witness:
SE Cor. 18-8-20 Fnd Plug
CL. Rd. West 2.3
PK in P.P. S 40° E 44.62'
PK in 10" Elm S 70° E 24.58'
PK in 8" Pine N 40° E 50.90'

Oct. 29, 1991

Strebs (W & A)
Southeast Corner
Section 18-8-20
(Fnd. Plug)
C/L Road - West 23' ±
P.K. Nail in Power Pole - S 40° E - 44.62'
P.K. Nail in 10" Hawthorn - S 70° E - 24.58'
P.K. Nail in 8" Pine - N 40° E - 50.90'

March 22, 1993

John Kamer W & A
Southeast Cor. 18-8-20
Fnd Plug
CL Road West 23' ±
P.K. Nail in PP S 40° E 44.62'
P.K. Nail in 10" Hawthorn S 70° E 24.58'
P.K. Nail in 8" Pine N 40° E 50.90'

SURVEY &
REMONUMENTATION

NOV 07 1994

COMMISSION

LIBER

3 PAGE 138