

REVIEWED BY THE BERRIEN COUNTY SURVEY PEER GROUP AS THE OFFICIAL CORNER UNDER MICHIGAN PUBLIC ACT 345 OF 1990

*Warren D. [Signature]*  
 NOV 20 1994  
 For corners in

Berrien County Remonumentation  
**LAND CORNER RECORDATION CERTIFICATE**  
 Filing Requirement of Act 74, Mich. P.A. 1970

REGISTER OF DEEDS  
 BERRIEN COUNTY MICHIGAN  
*[Signature]*

DEC 16 4 02 PM '94

RECORDED

<u>Berrien</u> (County)	Located In:	Corner Code #
1. Public Land Survey	T <u>8</u> R <u>19</u>	<u>A-1</u>
Comments: T75, R19W, A13	T _____ R _____	_____
T75, R20W, M13	T _____ R _____	<u>M-1</u>
T85, R20W, M1	T _____ R _____	_____
2. Property Controlling in Section	S _____ T _____ R _____	_____
3. Miscellaneous Property in Sec.	S _____ T _____ R _____	_____
4. Lot No. _____, Recorded Plat _____		
5. Private Claims _____		

Register of Deeds Stamp & File Number

	A	B	C	D	E	F	G	H	I	J	K	L	M
0													
2	6	5	4	3	2	1							
3													
4	7	8	9	10	11	12							
5													
6	18	17	16	15	14	13							
7													
8	19	20	21	22	23	24							
9													
10	30	29	28	27	26	25							
11													
12	31	32	33	34	35	36							
13													

I, Charles W. Barger, in a field survey on November, 19 94, do hereby certify that under requirements of P.A. 74, Michigan P.A. of 1970, the corner points mentioned in lines 1 and 2 above were in conformance with regulations and rules therefore as required in the current manual of survey instructions of the United States Department of the Interior, Bureau of Land Management or by a decree of a Court of Law and/or that the corner points mentioned in lines 3, 4 and 5 above were in conformance with the rules of the Michigan Board of Land Surveyors or by a Decree of a Court of Law; established, re-established, monumented, re-monumented, recovered, found as expressed below:

**NOTE: Not more than 4 corners, all in the same town and range, may be recorded on this certificate.**


A. Description of original monument and accessories and/or subsequent restoration:

July, 1829 - Lucius Lyons	80.00	Set post corner to Townships 7 & 8 South, Ranges 19 & 20 West	12/16/94	111#9004	A66
		Beech 8 S. 36 W. 39	12/16/94	111#9004	A66
		Svc. 24 N. 61 W. 36			STATE REMON FEE \$2.00

B. Description of corner evidence found and/or method applied in restoring or reestablishing corner:

A-1 Found Plug in Monument Box  
 Found PK nail in Power Pole S.45E., 45.0'  
 Found PK nail in Power Pole N.31E., 46.0'  
 Found PK nail in Power Pole S.40W., 39.2'  
 Center of Telephone Box N.44W., 42.2'

DEC 17 1995  
 [Stamp]

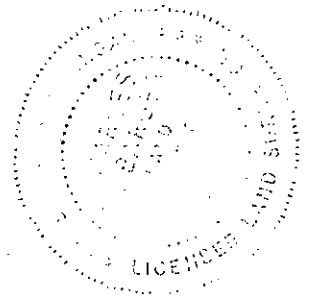

C. Description of monument for corner and accessories established to perpetuate locating the position of the corner:

A-1 1" Pipe set (1' Deep) w/2 1/2" Remonumentation Brass Cap in Monument Box over Stone  
 Set Witness Tag in Power Pole S.45E., 45.0'  
 Set Witness Tag in Power Pole N.31E., 46.0'  
 Set Witness Tag in Power Pole S.40W., 39.2'  
 Center of Telephone Box N.44W., 42.2'

And is accepted as a careful and faithful perpetuation of the position of the original corner.

Signed by Charles W. Barger P.S. Date December 16, 1994  
 Surveyor's Michigan License No. 31589

SOUTHEAST CORNER - SECTION 36-7-20  
NORTHEAST CORNER - SECTION 1-8-20  
SOUTHWEST CORNER - SECTION 31-7-19  
NORTHWEST CORNER - SECTION 6-8-19 (A-1)

JULY. 1829

Lucius Lyon L2, P247 Government Notes

80.00 Set post corner to Townships 7 & 8 South, Ranges 19 & 20 West

Beech 8 S. 36 W. 39  
Svc. 24 N. 61 W. 36

Circa 1945

Berrien County Road Commission

Hole in Pavement  
16" Ash N. 23 E. 58.4'  
8" Elm S. 72 W. 101.9'  
18" Elm S. 15 W. 169.2'  
6" Elm S 70 E. 87.1'  
Tel. Pole NW 107.9'

MAY. 1977

R. Beland L2, P250 Recorded Corner

Plug  
Tel. Pole N.W. 45.5'  
Elec. Pole S. 42 E 44.7'  
Ash N. 23 E. 58.7'  
Elm S. 72 W. 101.9'

MARCH. 1979

M. Rushlow L1100, P1023 Recorded Survey

Plug in Monument Box  
PK nail in P. Pole S. 45 E. 44.96'  
PK nail in P. Pole N. 45 W. 45.99'  
PK nail in P. Pole S. 45 W. 39.81'

NOV. 28, 1994

C.W. Barger

Found Plug in Monument Box  
Found PK nail in P. Pole S. 45 E. 45.0'  
Found PK nail in P. Pole N. 31 E. 46.0'  
Found PK nail in P. Pole S. 40 W. 39.2'  
Center of Tele. Box N. 44 W. 42.2'

1829-1835

1835-1895

LIBER

3 PAGE 213