

RAISED BY THE \_\_\_\_\_ COUNTY  
 SURVEY PEER GROUP AS THE  
 OFFICIAL CORNER UNDER MICHIGAN  
 PUBLIC ACT 345 OF 1980  
*John G. Kamer*  
 4-04-95

11/29/95 11142512 877  
 CORNER \$9.00  
 11/29/95 11143012 877  
 STATE FEE \$2.00

BERRIEN COUNTY REMONUMENTATION  
**LAND CORNER RECORDATION CERTIFICATE**  
 Filing Requirement of Act 74, Mich. P.A. 1970

For corners in

| BERRIEN<br>(County)                   | Located In:             | Corner Code # |
|---------------------------------------|-------------------------|---------------|
| 1. Public Land Survey                 | T 8S R 20W              | M-8           |
|                                       | T _____ R _____         | _____         |
|                                       | T _____ R _____         | _____         |
|                                       | T _____ R _____         | _____         |
| 2. Property Controlling<br>in Section | S _____ T _____ R _____ | _____         |
|                                       | S _____ T _____ R _____ | _____         |
| 3. Miscellaneous<br>Property in Sec.  | S _____ T _____ R _____ | _____         |
|                                       | S _____ T _____ R _____ | _____         |
| 4. Lot No. _____, Recorded Plat _____ |                         |               |
| 5. Private Claims _____               |                         |               |

RECORDED

Nov 29 3 40 PM '95

*Richard T. ...*  
 REGISTER OF DEEDS  
 BERRIEN COUNTY MICHIGAN  
 Register of Deeds Stamp & File Number

I, JOHN G. KAMER, in a field survey on NOVEMBER 16, 19 95, do hereby certify that under requirements of P.A. 74, Michigan P.A. of 1970, the corner points mentioned in lines 1 and 2 above were in conformance with regulations and rules therefore as required in the current manual of survey instructions of the United States Department of the Interior, Bureau of Land Management or by a decree of a Court of Law and/or that the corner points mentioned in lines 3, 4 and 5 above were in conformance with the rules of the Michigan Board of Land Surveyors or by a Decree of a Court of Law; established, re-established, monumented, re-monumented, recovered, found as expressed below:

|    | A  | B  | C  | D  | E  | F  | G | H | I | J | K | L | M |
|----|----|----|----|----|----|----|---|---|---|---|---|---|---|
| 2  | 6  | 5  | 4  | 3  | 2  | 1  |   |   |   |   |   |   |   |
| 3  |    |    |    |    |    |    |   |   |   |   |   |   |   |
| 4  | 7  | 8  | 9  | 10 | 11 | 12 |   |   |   |   |   |   |   |
| 5  |    |    |    |    |    |    |   |   |   |   |   |   |   |
| 6  | 18 | 17 | 16 | 15 | 14 | 13 |   |   |   |   |   |   |   |
| 7  |    |    |    |    |    |    |   |   |   |   |   |   |   |
| 8  | 19 | 20 | 21 | 22 | 23 | 24 |   |   |   |   |   |   |   |
| 9  |    |    |    |    |    |    |   |   |   |   |   |   |   |
| 10 | 30 | 29 | 28 | 27 | 26 | 25 |   |   |   |   |   |   |   |
| 11 |    |    |    |    |    |    |   |   |   |   |   |   |   |
| 12 | 31 | 32 | 33 | 34 | 35 | 36 |   |   |   |   |   |   |   |
| 13 |    |    |    |    |    |    |   |   |   |   |   |   |   |

**NOTE: Not more than 4 corners, all in the same town and range, may be recorded on this certificate.**


A. Description of original monument and accessories and/or subsequent restoration:  
 (SEE BACK.)

RECORDED  
 MAR 27 1996  
 COMMISSION

B. Description of corner evidence found and/or method applied in restoring or reestablishing corner:  
 FOUND R.R. SPIKE IN THE CENTERLINE OF SPRING CREEK ROAD.

C. Description of monument for corner and accessories established to perpetuate locating the position of the corner:  
 REMOVED R.R. SPIKE.  
 SET MON. BOX. SET STANDARD 3' X 1" PIPE WITH BRASS PLATE IN MON. BOX.  
 SET NAIL W/TAG IN 8" ELM S 08° W 26.10'  
 SET NAIL W/TAG IN 7" MAPLE S 29° E 38.60'  
 SET NAIL W/TAG IN RR TIE POST N 14° E 28.50'  
 SET NAIL W/TAG IN RR TIE POST N 33° E 31.60'  
 CORNER IS ACCEPTED AS A CAREFUL AND FAITHFUL PERPETUATION OF THE POSITION OF THE ORIGINAL CORNER.

Signed by *John G. Kamer*  
 Surveyor's Michigan License No. 27449

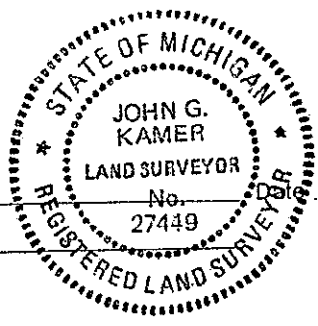

11-29-95

**E ¼ Corner 24-8-20  
Three Oaks Township  
M-8**

**1829**

Lucius Lyon  
7" Lynn at ¼ Section Corner  
15.55 Chains North of North  
Boundary Indiana

**July 22, 1977**

Maurice R. Rushlow, W&A Survey Liber 1059, Pg. 276  
RR Spike 1023.05' N of  
North Boundary, Indiana  
Accessories Cor. of Fence Post North 28.24'  
Power Pole N30°E 92.12'  
3" Sassafrass South 26.23'

**October 10, 1978**

Maurice R. Rushlow, W&A Survey Liber 1098, Pg 615  
RR Spike 1023.05' N of North Boundary Indiana  
Accessories same as 1977

**April 22, 1994**

John G. Kamer, W&A  
Found RR Spike 1023.38' N of North Boundary, Indiana  
Accessories PK in 8" Elm South 26.15'  
PK in 6" Maple S30°E 38.69'  
PK in RR Tie Post N05°E 28.43'  
PK in RR Tie Post N25°E 31.50'

**March 7, 1995**

John G. Kamer, W&A  
Found RR Spike 1023.38' N of North Boundary, Indiana  
Accessories Same as April 22, 1994