

RAISED BY THE _____ COUNTY
 SURVEY PEER GROUP AS THE
 OFFICIAL CORNER UNDER MICHIGAN
 PUBLIC ACT 345 OF 1990

[Signature]
11-A-96

**REMONUMENTATION
 LAND CORNER RECORDATION CERTIFICATE**
 Filing Requirement of Act 74, Mich. P.A. 1970


RECORDED

DEC 26 11 47 AM '96

[Signature]
 REGISTERED
 PROFESSIONAL SURVEYOR

For corners in S 1/4 Post, Section 19 - New Buffalo Township
BERRIEN COUNTY Located In: _____ Corner Code # _____
 (County)

- 1. Public Land Survey T 8S R 21W B-9
- ON STATE LINE
- 2. Property Controlling in Section S T R
- 3. Miscellaneous Property in Sec. S T R
- 4. Lot No. _____, Recorded Plat _____
- 5. Private Claims _____

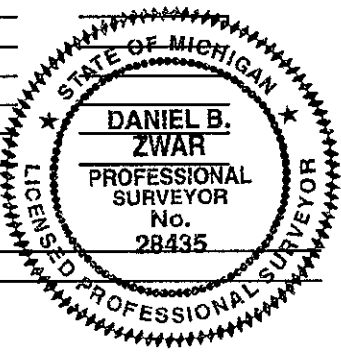

12/26/96 111#9870 A99
 CORNER \$7.00
 12/26/96 111#9870 A99
 STATE REMON FEE \$2.00
 Register of Deeds Stamp & File Number

1	A	B	C	D	E	F	G	H	I	J	K	L	M
2		6		5		4		3		2		1	
3													
4		7		8		9		10		11		12	
5													
6		18		17		16		15		14		13	
7													
8		19		20		21		22		23		24	
9													
10		30		29		28		27		26		25	
11													
12		31		32		33		34		35		36	
13													

I, DANIEL B. ZWAR, in a field survey on DECEMBER 17, 1996, do hereby state that under requirements of P.A. 74, Michigan P.A. of 1970, the corner points mentioned in lines 1 and 2 above were in conformance with regulations and rules therefore as required in the current manual of survey instructions of the United States Department of the Interior, Bureau of Land Management or by a decree of a Court of Law and /or that the corner points mentioned in lines 3, 4 and 5 above were in conformance with the rules of the Michigan Board of Land Surveyors or by a Decree of a Court of Law; established, re-established, monumented, recovered, found as expressed below:

NOTE: Not more than 2 corners, all in the same town and range, may be recorded on this certificate.

A. Description of original monument and accessories and/or subsequent restoration:

ORIGINAL GOVERNMENT SURVEY
 DATE: NO GLO RECORD FOUND THAT THIS CORNER SET

ORIGINAL WITNESS:
 1827 - E.P. KENDRICKS ESTABLISHED N. LINE OF INDIANA--BOOK 2, PAGES 429 & 430.
 1830 - LUCIUS LYON SET SOUTHWEST AND SOUTHEAST CORNERS OF SECTION 19, BUT NOT SOUTH 1/4 POST. BOOK 2, PAGES 399, 400, 410 & 411.

SUBSEQUENT PERPETUATION
 DATE, DESCRIPTION, BY, WITNESS

1921 - VETTER/JOHNSTON
 SHOWS STONE- BUT THIS DOESN'T MENTION THAT IT IS SECTION CORNER AND DOESN'T FIT DISTANCE EAST FROM R.R. IT REFERENCES. - I BELIEVE THIS STONE IS JUST A PROPERTY CORNER 200 OR 300 FEET WEST OF THE SECTION CORNER.

1978 - E.R. STEFAN
 CONCRETE MON.
 SHOWS IRON 35' TO EAST

1981 - V.J. STREBS
 SHOWS SOUTH 1/4 CORNER WITH
 IRON 32.0' TO EAST.

1996 - D. B. ZWAR
 FOUND CONCRETE MONUMENT
 OLD FENCE TO NORTH
 FOUND IRON PIPE 34.2 FEET TO EAST
 OUR DEED CALLED FOR 2608' - SOUTH 1/4 POST TO SE CORNER - WE MEASURED 2609.12'.

B. Description of corner evidence found and/or method applied in restoring or reestablishing corner:

FOUND 4" DIAMETER CONCRETE MONUMENT. STRADDLED AND REMOVED. FOUND IT TO BE 24" LONG. DUG TO 3 1/2 FEET DEEP AND ONLY ENCOUNTERED UNDISTURBED SAND. THIS POSITION WAS NOT ESTABLISHED BY ORIGINAL GOVERNMENT SURVEYORS. THIS MONUMENT IS ACCEPTED AS THE BEST AVAILABLE EVIDENCE OF THE POSITION OF THE CORNER.

C. Description of monument for corner and accessories established to perpetuate locating the position of the corner:

PLACED STANDARD BERRIEN COUNTY REMONUMENTATION PROGRAM CONCRETE MONUMENT WITH BRASS CAP TO STRADDLES FOR MONUMENT. ALSO PLACED PLASTIC SURVEY MARKER NEARBY.
 WITNESSES: NAIL WITH TAG IN 15" OAK EAST 20.50'
 IRON PIPE EAST 34.2'
 NAIL WITH TAG IN 10" OAK 520°E 21.06'
 NAIL WITH TAG IN 6" MAPLE WEST 26.64'
 NAIL WITH TAG IN 10" OAK N15°W 40.06'

SURVEY &
 REMONUMENTATION

MAY 20 1997

Signed by Daniel B Zwar
 Surveyor's Michigan License No. 28435

COMMISSIONER
 Date Dec 18, 1996