SURVEY & REMONUMENTATION

JAN 2 3 1996

COMMISSION

BRANCH COUNTY REMONUMENTATION CORNER

LAND CORNER RECORDATION CERTIFICATE

Filing Requirement of Act 74, Mich. P.A. 1970

STATE OF MICHIGAN
Branch County
Recorded

09-28-1995 10:20:07

Linda Lee Morrison-Mathews
REGISTER OF DEEDS

Liber 00003 Page 0022

Register of Deeds Stamp & File Number

For corners in

~~BRANCH~~ (County)

	Located In:	Corner Code ##
GIRARD TWP.		
1. Public Land Survey	T 5 S R 6 W	C-9
	T ___ R ___	
	T ___ R ___	
	T ___ R ___	
2. Property Controlling	S ___ T ___ R ___	
in Section	S ___ T ___ R ___	
3. Miscellaneous	S ___ T ___ R ___	
Property in Sec.	S ___ T ___ R ___	

4. Lot No. _____ , Recorded Plat _____
5. Private Claims _____

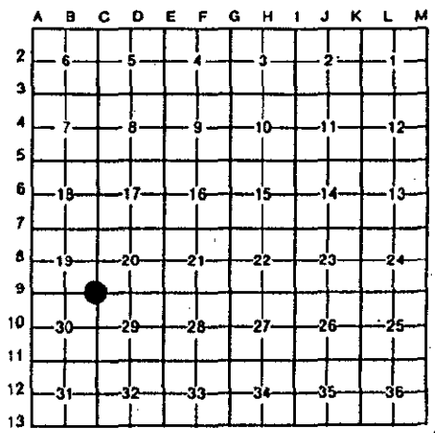

I, Edward W. Reed, in a field survey on June 14, 19 95, do hereby certify that under requirements of P.A. 74, Michigan P.A. of 1970, the corner points mentioned in lines 1 and 2 above were in conformance with regulations and rules therefore as required in the current manual of survey instructions of the United States Department of the Interior, Bureau of Land Management or by a decree of a Court of Law and/or that the corner points mentioned in lines 3, 4 and 5 above were in conformance with the rules of the Michigan Board of Land Surveyors or by a Decree of a Court of Law; established, re-established, monumented, re-monumented, recovered, found as expressed below:

NOTE: Not more than 4 corners, all in the same town and range, may be recorded on this certificate.

A. Description of original monument and accessories and/or subsequent restoration:

CORNER COMMON TO SECTIONS 19, 20 29 & 30, GIRARD TWP., BRANCH COUNTY, MI.
1825: Robert Clark, Jr., Deputy Surveyor-set corner
1856: A. R. Day, Deputy County Surveyor-small stones & brick bats
1872: J. H. Bennett-found stone & chain
1904: Charles Hamilton-found pointed stone with piece of cable chain & stone. Put brick, mortar, & earthenware around
1964: E. R. Reed-iron
1973: E. R. Reed, County Surveyor,-recorded corner in L.C.R. #86-iron rod over stone

B. Description of corner evidence found and/or method applied in restoring or reestablishing corner:

Found iron pipe with ½" bolt in top
Set cast iron box, ½" iron and remonumentation cap flush with road surface

ACCEPTED BY THE BRANCH COUNTY SURVEY PEER GROUP AS THE OFFICIAL CORNER UNDER MICHIGAN PUBLIC ACT 345 OF 1990 AT A MEETING HELD ON 9-13-95
E.R. Reed, Co. Rep.

C. Description of monument for corner and accessories established to perpetuate locating the position of the corner:

N32°W 49.5'-face of power pole
S78°E 93.2'-brace pole
S23°W 108.9'-power pole
In road intersection
S86°W 146.6'-to face of telephone pole
N15°W 89.1'-SE corner of telephone pedestal

And is accepted as a careful and faithful perpetuation of the position of the original corner.

STATE OF MICHIGAN
EDWARD W. REED
LAND SURVEYOR
NO. 33985
LICENSED LAND SURVEYOR

Signed by Edward W. Reed Date June 14, 1995
Surveyor's Michigan License No. 33985

FORM APPROVED BY MICHIGAN STATE BOARD OF LAND SURVEYORS, JAN. 28, 1971
REVISED MAY 14, 1975
REVISED JAN., 1983