

**SURVEY &
MONUMENTATION**

BRANCH COUNTY REMONUMENTATION CORNER STATE OF MICHIGAN
LAND CORNER RECORDATION CERTIFICATE Branch County
Filing Requirement of Act 74, Mich. P.A. 1970 Recorded

JAN 23 1996

For corners in

BRANCH

COMMISSION

(County)

Located In:

Corner Code #

GIRARD

1. Public Land Survey	T	5S	R	6W	C-11
	T		R		
	T		R		
	T		R		
2. Property Controlling in Section	S		T	R	
	S		T	R	
3. Miscellaneous Property in Sec.	S		T	R	
	S		T	R	

09-28-1995 10:20:21

Linda Lee Morrison-Mathews
REGISTER OF DEEDS

Liber 00003 Page 0024

Register of Deeds Stamp & File Number

4. Lot No. _____, Recorded Plat _____
5. Private Claims _____

I, Edward W. Reed, in a field survey on June 16, 19 95, do hereby certify that under requirements of P.A. 74, Michigan P.A. of 1970, the corner points mentioned in lines 1 and 2 above were in conformance with regulations and rules therefore as required in the current manual of survey instructions of the United States Department of the Interior, Bureau of Land Management or by a decree of a Court of Law and/or that the corner points mentioned in lines 3, 4 and 5 above were in conformance with the rules of the Michigan Board of Land Surveyors or by a Decree of a Court of Law; established, re-established, monumented, re-monumented, recovered, found as expressed below:

	A	B	C	D	E	F	G	H	I	J	K	L	M
2	6	5	4	3	2	1							
3	7	8	9	10	11	12							
4													
5													
6	18	17	16	15	14	13							
7													
8	19	20	21	22	23	24							
9													
10	30	29	28	27	26	25							
11													
12	31	32	33	34	35	36							
13													

NOTE: Not more than 4 corners, all in the same town and range, may be recorded on this certificate.

A. Description of original monument and accessories and/or subsequent restoration:

CORNER COMMON TO SECTIONS 29, 30, 31, AND 32, T5S, R6W, GIRARD TWP., BRANCH COUNTY, MI

- 1825: Robert Clark, Jr., Deputy Surveyor, -set corner
Old notes of H. L. Russell, County Surveyor, indicates stone, brick and wood stake
H. L. Russell-tied Plat of "Austin's Landing" to corner
1957: H. L. Russell-tied Plat of "Neibles Landing" to corner
1969: E. R. Reed, County Surveyor, -survey tied to corner
1970: E. J. McCombs, Consumers Power Co., Surveyor, -found large stone, brick, wood stake placed T-iron over top
1977: E. R. Reed-recorded corner L.C.R. #195, T-iron over stone
1980: F. J. Cutcher-recorded corner L.C.R. #II-38, found iron

B. Description of corner evidence found and/or method applied in restoring or reestablishing corner:

Found 1/2" iron rod
Set cast iron monument box & placed remonumentation cap on iron


ACCEPTED BY THE BRANCH COUNTY SURVEY PEER GROUP AS THE OFFICIAL CORNER UNDER MICHIGAN PUBLIC ACT 345 OF 1990 AT A MEETING HELD ON
9-13-95

E. R. Reed, C.S.

C. Description of monument for corner and accessories established to perpetuate locating the position of the corner:

- 2' W of centerline of N-S road
5' S of centerline of road to W
N40°W 46.4'-steel fence corner post
N45°E 47.4'-SW corner of telephone pedestal
S40°W 43.4'-36" oak tree
S10°E 167.0'-to face of power pole
S 80°W 84.90'-nail and washer 3' up N side of 48" oak

And is accepted as a careful and faithful perpetuation of the position of the original corner.

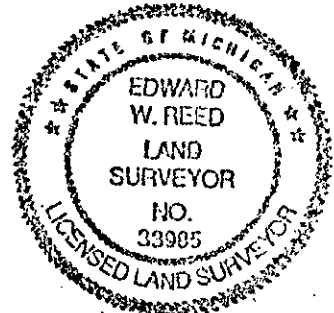

Signed by Edward W. Reed
Surveyor's Michigan License No. 33985

Date June 16, 1995