

SURVEY & MONUMENTATION

JAN 23 1996

BRANCH COUNTY REMONUMENTATION CORNER LAND CORNER RECORDATION CERTIFICATE

Filing Requirement of Act 74, Mich. P.A. 1970

For corners in **COMMISSION**

BRANCH (County)	Located In:	Corner Code #
GIRARD TWP.	T <u>5</u> S R <u>6</u> W	<u>C-13</u>
1. Public Land Survey	T _____ R _____	_____
	T _____ R _____	_____
	T _____ R _____	_____
2. Property Controlling in Section	S _____ T _____ R _____	_____
	S _____ T _____ R _____	_____
3. Miscellaneous Property in Sec.	S _____ T _____ R _____	_____
	S _____ T _____ R _____	_____

STATE OF MICHIGAN
Branch County
Recorded

09-28-1995 10:20:30

Linda Lee Morrison-Mathews
REGISTER OF DEEDS

Liber **00003** Page **0025**

Register of Deeds Stamp & File Number

- 4. Lot No. _____, Recorded Plat _____
- 5. Private Claims _____

	A	B	C	D	E	F	G	H	I	J	K	L	M
2	6	5	4	3	2	1							
3													
4	7	8	9	10	11	12							
5													
6	13	17	16	15	14	13							
7													
8	19	20	21	22	23	24							
9													
10	30	29	28	27	26	25							
11													
12	31	32	33	34	35	36							
13													

I, Edward W. Reed, in a field survey on August 22, 19 95, do hereby certify that under requirements of P.A. 74, Michigan P.A. of 1970, the corner points mentioned in lines 1 and 2 above were in conformance with regulations and rules therefore as required in the current manual of survey instructions of the United States Department of the Interior, Bureau of Land Management or by a decree of a Court of Law and/or that the corner points mentioned in lines 3, 4 and 5 above were in conformance with the rules of the Michigan Board of Land Surveyors or by a Decree of a Court of Law; established, re-established, monumented, re-monumented, recovered, found as expressed below:

NOTE: Not more than 4 corners, all in the same town and range, may be recorded on this certificate.

A. Description of original monument and accessories and/or subsequent restoration:
SOUTHWEST CORNER OF SECTION 32, GIRARD TWP., BRANCH COUNTY, MI

- 1825: John Mallet, Dep. Surveyor, set corner
Survey in County Surveyor's records Liber 1, Page 224, unknown surveyor-stone & brick
- 1946: E.R. Reed, corner attested by Reed to be corner as shown to him by H. L. Russell, County Surveyor
- 1973: E. R. Reed, County Surveyor, found 2 1/2" pipe used in previous surveys, recorded L.C.R.C. #66
Plat of "Adolph Shores" tied to corner

B. Description of corner evidence found and/or method applied in restoring or reestablishing corner:

Found 2" pipe 14" deep with flagging
Set 1/2" x 18" rebar in cast iron box flush with road surface


ACCEPTED BY THE BRANCH COUNTY SURVEY PRER GROUP AS THE OFFICIAL CORNER UNDER MICHIGAN PUBLIC ACT 345 OF 1990 AT A MEETING HELD ON 9-13-95

E.R. Reed Co. Rep.

C. Description of monument for corner and accessories established to perpetuate locating the position of the corner:

- W 76.7'-concrete post
- East 13.0'-12" maple
- South 88.5'-NW corner small shed
- N 30.0'-S edge pavement
- West 167.70 - NW cor. Sec. 5, T6S, R6W

And is accepted as a careful and faithful perpetuation of the position of the original corner.

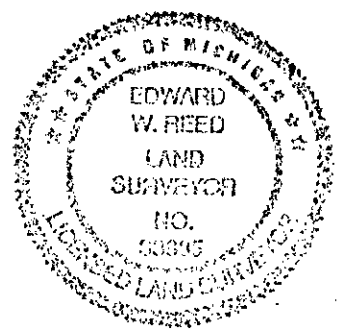

Signed by Edward W. Reed
Surveyor's Michigan License No. _____

Date August 22, 1995