SURVEY &
REMONUMENTATION

MAR 1 3 1998

SECTION

STATE OF MICHIGAN
Branch County
Recorded

10-22-1997 09:55:53

Linda Lee Morrison-Mathews
REGISTER OF DEEDS

Liber 00003 Page 0158

Register of Deeds Stamp & File Number

BRANCH COUNTY REMONUMENTATION CORNER
LAND CORNER RECORDATION CERTIFICATE
Filing Requirement of Act 74, Mich. P.A. 1970

For corners in

BRANCH
(County)

GIRARD TWP.

		Located in:	Corner Code #
1. Public Land Survey		T 5 S R 6 W	D-1
		T___ R___	
		T___ R___	
		T___ R___	
2. Property Controlling	S___	T___ R___	
in Section	S___	T___ R___	
3. Miscellaneous	S___	T___ R___	
Property in Sec.	S___	T___ R___	

4. Lot No. _____ , Recorded Plat _____
5. Private Claims _____

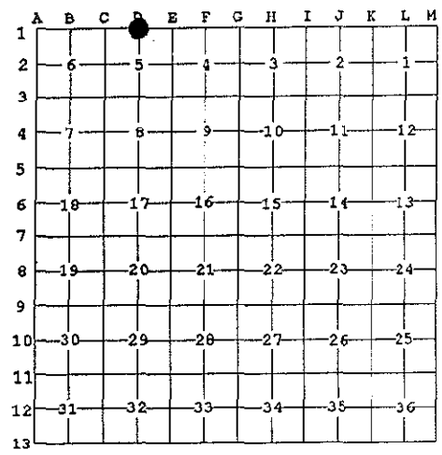

I, EDWARD W. REED, in a field survey on JULY 18, 1997 do hereby state that under requirements of P.A. 74, Michigan P.A. of 1970, the corner points mentioned in lines 1 and 2 above were in conformance with regulations and rules therefore as required in the current manual of survey instructions of the United States Department of the Interior, Bureau of Land Management or by a decree of a Court of Law and /or that the corner points mentioned in lines 3, 4 and 5 above were in conformance with the rules of the Michigan Board of Land Surveyors or by a Decree of a Court of Law; established, re-established, monumented, recovered, found as expressed below:

NOTE: Not more than 2 corners, all in the same town and range, may be recorded on this certificate.

A. Description of original monument and accessories and/or subsequent restoration:
QUARTER CORNER OF SECTION 5 ON COUNTY LINE

1892: ID MINER, CO SURVEYOR - SET 3" FIRECLAY DRAIN TILE FILLED WITH COAL
1962: E.R.REED, CO SURVEYOR - FOUND REMAINS OF TILE DESTROYED BY ROAD BUILDING. SET 3/4" PIPE FROM WITNESS.

B. Description of corner evidence found and/or method applied in restoring or reestablishing corner:

FOUND 3/4" IRON ROD 2.8' BELOW ROAD GRADE, SET ½" IRON AND REMON CAP IN CI-MONUMENT BOX FLUSH WITH ROAD SURFACE

C. Description of monument for corner and accessories established to perpetuate locating the position of the corner:
½" IRON ROD IN CI-MONUMENT BOX

CONCRETE ANCHOR POST, SOUTH 31.4'
DRIVEWAY CULVERT, S48W 30.72'
P. POLE, N44E 138.6' TO FACE
CONCRETE POST, S55W 52.0' TO FACE
1.0' NORTH OF C/L ROAD

ACCEPTED BY THE BRANCH COUNTY SURVEY PEER GROUP AS THE OFFICIAL CORNER UNDER MICHIGAN PUBLIC ACT 345 OF 1990 AT A MEETING HELD ON 9-10-97.
E.R. Reed, P.S. Co. Rep.
E.R. REED

AND IS ACCEPTED AS A CAREFUL AND FAITHFUL PERPETUATION OF THE POSITION OF THE ORIGINAL CORNER

Signed by Edward W. Reed Date JULY 18, 1997
EDWARD W. REED
Surveyor's Michigan License No. 33985

STATE OF MICHIGAN
EDWARD W. REED
LAND SURVEYOR
NO. 33985
LICENSED LAND SURVEYOR

1971

FORM APPROVED BY MICHIGAN STATE BOARD OF PROFESSIONAL SURVEYORS, JAN. 28
REVISED MAY 14,1975
REVISED JAN, 198
REVISED OCT., 199