

**SURVEY &
MONUMENTATION**

JAN 23 1996

**BRANCH COUNTY REMONUMENTATION CORNER
LAND CORNER RECORDATION CERTIFICATE**

Filing Requirement of Act 74, Mich. P.A. 1970

STATE OF MICHIGAN
Branch County
Recorded

For corners in

COMMISSION

BRANCH _____
(County)

Located In:

Corner Code #/

GIRARD TWP.

1. Public Land Survey	T <u>5</u> S R <u>6</u> W	<u>E-11</u>
	T _____ R _____	_____
	T _____ R _____	_____
	T _____ R _____	_____
2. Property Controlling in Section	S _____ T _____ R _____	_____
	S _____ T _____ R _____	_____
3. Miscellaneous Property in Sec.	S _____ T _____ R _____	_____
	S _____ T _____ R _____	_____

09-28-1995 10:20:45

Linda Lee Morrison-Mathews
REGISTER OF DEEDS

Liber **00003** Page **0027**

Register of Deeds Stamp & File Number

4. Lot No. _____, Recorded Plat _____
5. Private Claims _____

A	B	C	D	E	F	G	H	I	J	K	L	M
2	6	5	4	3	2	1						
3												
4	7	8	9	10	11	12						
5												
6	18	17	16	15	14	13						
7												
8	19	20	21	22	23	24						
9												
10	30	29	28	27	26	25						
11												
12	31	32	33	34	35	36						
13												

I, Edward W. Reed, in a field survey on June 14, 1995, do hereby certify that under requirements of P.A. 74, Michigan P.A. of 1970, the corner points mentioned in lines 1 and 2 above were in conformance with regulations and rules therefore as required in the current manual of survey instructions of the United States Department of the Interior, Bureau of Land Management or by a decree of a Court of Law and/or that the corner points mentioned in lines 3, 4 and 5 above were in conformance with the rules of the Michigan Board of Land Surveyors or by a Decree of a Court of Law; established, re-established, monumented, re-monumented, recovered, found as expressed below:

NOTE: Not more than 4 corners, all in the same town and range, may be recorded on this certificate.

A. Description of original monument and accessories and/or subsequent restoration:

- SECTION CORNER COMMON TO SECTIONS 28, 29, 32 & 33, GIRARD TWP., BRANCH COUNTY, MI.
1825: Robert Clark, Jr., Deputy Surveyor-set corners
1910: J. J. Cox-found old stake in brick, set 3/4" gas pipe
1957: E. R. Reed, County Surveyor, found pipe
1957: E. R. Reed tied corner to Plat of "Stevens Shore"
1971: E. R. Reed, survey described iron rod beside stone
1978: F. J. Cutcher-found 1 1/4" solid iron, recorded in L.C.R. #224

B. Description of corner evidence found and/or method applied in restoring or reestablishing corner:

- Found monument box, 1 1/4" solid iron rod
Set 2 extension rings, 1/2" rebar iron and remonumentation cap


ACCEPTED BY THE BRANCH COUNTY
SURVEY PEER GROUP AS THE OFFICIAL
CORNER UNDER MICHIGAN PUBLIC ACT 345
OF 1990 AT A MEETING HELD ON
7-13-95

E. R. Reed C. Rep.

C. Description of monument for corner and accessories established to perpetuate locating the position of the corner:

- 8.7' W of centerline of road
W 15.28'-square concrete anchor post
N01E 127.10'-SW corner of house
N46E 55.60'-telephone pedestal

And is accepted as a careful and faithful perpetuation of the position of the original corner.

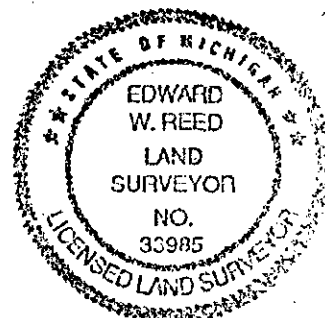

Signed by Edward W. Reed
Surveyor's Michigan License No. 33985

Date June 14, 1995