

**SURVEY &
MONUMENTATION**

**BRANCH COUNTY REMONUMENTATION CORNER
LAND CORNER RECORDATION CERTIFICATE
Filing Requirement of Act 74, Mich. P.A. 1970**

JAN 23 1996

COMMISSION

For corners in

BRANCH _____
(County)

Located In:

Corner Code -#

GIRARD TWP.

- | | | |
|---------------------------------------|-----------------------------|-------------|
| 1. Public Land Survey | T <u>5</u> -S R <u>6</u> -W | <u>E-13</u> |
| | T _____ R _____ | _____ |
| | T _____ R _____ | _____ |
| | T _____ R _____ | _____ |
| 2. Property Controlling
in Section | S _____ T _____ R _____ | _____ |
| | S _____ T _____ R _____ | _____ |
| 3. Miscellaneous
Property in Sec. | S _____ T _____ R _____ | _____ |
| | S _____ T _____ R _____ | _____ |

STATE OF MICHIGAN
Branch County
Recorded

09-28-1995 10:20:52

Linda Lee Morrison-Mathews
REGISTER OF DEEDS

Liber **00003** Page **0028**
Register of Deeds Stamp & File Number

4. Lot No. _____, Recorded Plat _____
5. Private Claims _____

	A	B	C	D	E	F	G	H	I	J	K	L	M
2	6	5	4	3	2	1							
3													
4	7	8	9	10	11	12							
5													
6	18	17	16	15	14	13							
7													
8	19	20	21	22	23	24							
9													
10	30	29	28	27	26	25							
11													
12	31	32	33	34	35	36							
13													

I, Edward W. Reed, in a field survey on June 15, 1995, do hereby certify that under requirements of P.A. 74, Michigan P.A. of 1970, the corner points mentioned in lines 1 and 2 above were in conformance with regulations and rules therefore as required in the current manual of survey instructions of the United States Department of the Interior, Bureau of Land Management or by a decree of a Court of Law and/or that the corner points mentioned in lines 3, 4 and 5 above were in conformance with the rules of the Michigan Board of Land Surveyors or by a Decree of a Court of Law; established, re-established, monumented, re-monumented, recovered, found as expressed below:

NOTE: Not more than 4 corners, all in the same town and range, may be recorded on this certificate.

A. Description of original monument and accessories and/or subsequent restoration:

CORNER COMMON TO SECTIONS 32 & 33, GIRARD TWP. & SECTIONS 4 & 5, COLDWATER TWP. BRANCH COUNTY, MI.

1826: Robert Clark, Jr., Deputy Surveyor, -set corner

1975: Robert Burris, Sr. -set corner @ GLO offset from Coldwater corner. Set railroad spike Recorded L.C.R. #132

E. R. Reed, field notes. Found stone & tin & railroad spike set by Burris

1982: E. R. Reed-Plat of "Templar Beach" tied to corner

B. Description of corner evidence found and/or method applied in restoring or reestablishing corner:

Found railroad spike


Set 1/2" x 18" rebar iron & remonumentation cap in cast iron monument box

ACCEPTED BY THE BRANCH COUNTY
SURVEY PEER GROUP AS THE OFFICIAL
CORNER UNDER MICHIGAN PUBLIC ACT 345
OF 1990 AT A MEETING HELD ON
9-13-95
E.R. Reed C. Rep.

C. Description of monument for corner and accessories established to perpetuate locating the position of the corner:

- N65°W 38.8'-to near face of power pole
- N45°E 54.8'-to near face of power pole
- S55°W 65.4'-to center of 72" walnut tree
- West 15.84'-NW corner, Section 4, T6S, R6W

And is accepted as a careful and faithful perpetuation of the position of the original corner.

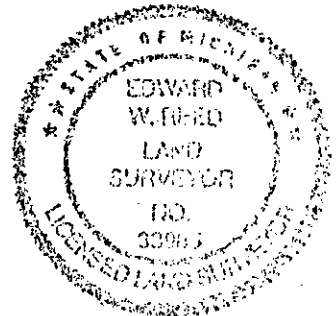

Signed by Edward W. Reed
Surveyor's Michigan License No. 33985

Date June 15 1995