

**SURVEY &
MONUMENTATION**

BRANCH COUNTY REMONUMENTATION CORNER
JAN 23 1996 **LAND CORNER RECORDATION CERTIFICATE** Liber **000003** Page **0029**
 Filing Requirement of Act 74, Mich. P.A. 1970

For corners in
BRANCH

COMMISSION

Located In: Corner Code #

(County)
GIRARD TWP.

- | | | |
|------------------------------------|-------------------------|------------|
| 1. Public Land Survey | T <u>5S</u> R <u>6W</u> | <u>F-7</u> |
| | T _____ R _____ | _____ |
| | T _____ R _____ | _____ |
| | T _____ R _____ | _____ |
| 2. Property Controlling in Section | S _____ T _____ R _____ | _____ |
| | S _____ T _____ R _____ | _____ |
| 3. Miscellaneous Property in Sec. | S _____ T _____ R _____ | _____ |
| | S _____ T _____ R _____ | _____ |

STATE OF MICHIGAN
 Branch County
 Recorded

09-28-1995 10:20:59

Linda Lee Morrison-Mathews
 REGISTER OF DEEDS

Register of Deeds Stamp & File Number

4. Lot No. _____, Recorded Plat _____
 5. Private Claims _____

I, Edward W. Reed, in a field survey on June 19, 19 95, do hereby certify that under requirements of P.A. 74, Michigan P.A. of 1970, the corner points mentioned in lines 1 and 2 above were in conformance with regulations and rules therefore as required in the current manual of survey instructions of the United States Department of the Interior, Bureau of Land Management or by a decree of a Court of Law and/or that the corner points mentioned in lines 3, 4 and 5 above were in conformance with the rules of the Michigan Board of Land Surveyors or by a Decree of a Court of Law; established, re-established, monumented, re-monumented, recovered, found as expressed below:

	A	B	C	D	E	F	G	H	I	J	K	L	M
2	6	5	4	3	2	1							
3													
4	7	8	9	10	11	12							
5													
6	18	17	16	15	14	13							
7													
8	19	20	21	22	23	24							
9													
10	30	29	28	27	26	25							
11													
12	31	32	33	34	35	36							
13													

NOTE: Not more than 4 corners, all in the same town and range, may be recorded on this certificate.


- A. Description of original monument and accessories and/or subsequent restoration:
 QUARTER CORNER COMMON TO SECTIONS 16 & 21, GIRARD TWP., BRANCH COUNTY, MI.
 1826: Robert Clark, Jr., Deputy Surveyor, -set corner
 1882: M. Knowles, Deputy Surveyor-used corner
 1946: H. L. Russell, County Surveyor, -survey tied to corner
 1955: E. R. Reed, County Surveyor, -survey tied to corner
 1991: E. W. Reed, Surveyor, -survey tied to corner

- B. Description of corner evidence found and/or method applied in restoring or reestablishing corner:
 Found 3/4" pipe with bolt in center
 Set cast iron monument box flush with road surface
 Set 1/2" iron inside of 3/4" pipe with remonumentation cap

ACCEPTED BY THE BRANCH COUNTY SURVEY PEER GROUP AS THE OFFICIAL CORNER UNDER MICHIGAN PUBLIC ACT 345 OF 1990 AT A MEETING HELD ON

9-13-95
E.R. Reed Co. Rep.

- C. Description of monument for corner and accessories established to perpetuate locating the position of the corner:
 S04°W 31.9' -to face of power pole
 S70°W 62.8' -to telephone pedestal
 N06°E 51.9' -to power pole
 S65°E 78.1' to center of 80" maple tree
 In centerline of road

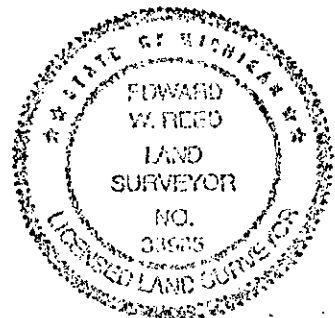

And is accepted as a careful and faithful perpetuation of the position of the original corner.

Signed by Edward W. Reed Date June 19, 1995
 Surveyor's Michigan License No. 3985