

SURVEY & REMONUMENTATION

MAR 13 1998

SECTION

**BRANCH COUNTY REMONUMENTATION CORNER
LAND CORNER RECORDATION CERTIFICATE**
STATE OF MICHIGAN
Branch County
Filing Requirement of Act 74, Mich. P.A. 1970

For corners in

<u>BRANCH</u> (County)	Located In:	Corner Code #
GIRARD TWP.	T 5 S R 6 W	G-1
1. Public Land Survey	T ___ R ___	_____
	T ___ R ___	_____
	T ___ R ___	_____
2. Property Controlling in Section	S ___ T ___ R ___	_____
	S ___ T ___ R ___	_____
3. Miscellaneous Property in Sec.	S ___ T ___ R ___	_____
	S ___ T ___ R ___	_____

Recorded
10-22-1997 09:56:23

Linda Lee Morrison-Mathews
REGISTER OF DEEDS

Liber 00003 Page 0162

Register of Deeds Stamp & File Number

4. Lot No. _____, Recorded Plat _____
5. Private Claims _____

I, EDWARD W. REED, in a field survey on JULY 18, 1997 do hereby state that under requirements of P.A. 74, Michigan P.A. of 1970, the corner points mentioned in lines 1 and 2 above were in conformance with regulations and rules therefore as required in the current manual of survey instructions of the United States Department of the Interior, Bureau of Land Management or by a decree of a Court of Law and /or that the corner points mentioned in lines 3, 4 and 5 above were in conformance with the rules of the Michigan Board of Land Surveyors or by a Decree of a Court of Law; established, re-established, monumented, recovered, found as expressed below:

NOTE: Not more than 2 corners, all in the same town and range, may be recorded on this certificate.

A. Description of original monument and accessories and/or subsequent restoration:
NORTHWEST CORNER SECTION 3, NOTHEAST CORNER SECTION 4,
GIRARD

1825: ROBERT CLARK, jr, DEPT. SURVEYOR - SET CORNER
1971: E.R. REED, CO. SURVEYOR - CORNER OBLITERATED BY RECENT ROAD CONSTRUCTION, RESET BY SINGLE PROPORTIONATE METHOD, RECORDED IN LCRC # 0010 SET 1" GAS PIPE

B. Description of corner evidence found and/or method applied in restoring or reestablishing corner:

FOUND 1" GAS PIPE AS DESCRIBED IN LCRC #0010

C. Description of monument for corner and accessories established to perpetuate locating the position of the corner:
SET 1/2" X 18" REBAR IRON WITH REMON CAP IN CI-MONUMENT BOX FLUSH WITH ROAD SURFACE

14" SHAG HICKORY, N40E 40.1' TO CENTER
4" OAK, N45W 42.93' TO CENTER
4" CHERRY, N21W 38.61' TO CENTER
8" HICKORY N5E 54.75' TO CENTER
1.2 SOUTH OF CENTERLINE OF E-W ROAD


AND IS ACCEPTED AS A CAREFUL AND FAITHFUL PERPETUATION OF THE POSITION OF THE ORIGINAL CORNER

Signed by Edward W. Reed

EDWARD W. REED

Surveyor's Michigan License No. 33985

Date JULY 18, 1997

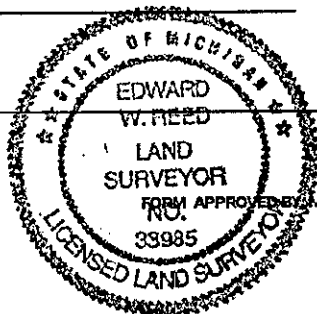

ACCEPTED BY THE BRANCH COUNTY SURVEY PEER GROUP AS THE OFFICIAL CORNER UNDER MICHIGAN PUBLIC ACT 345 OF 1990 AT A MEETING HELD ON

9-10-97
E.R. Reed P.S. Co. Rep.
E.R. REED

	A	B	C	D	E	F	G	H	I	J	K	L	M
1													
2	6		5		4		3		2		1		
3													
4	7		8		9		10		11		12		
5													
6	16		17		16		15		14		13		
7													
8	19		20		21		22		23		24		
9													
10	30		29		28		27		26		25		
11													
12	31		32		33		34		35		36		
13													