

**SURVEY &  
REMONUMENTATION**

FEB 08 1999

**SECTION**

**BRANCH COUNTY REMONUMATION PROGRAM  
LAND CORNER RECORDATION CERTIFICATE  
Filing Requirement of Act 74, Mich. P.A. 1970**

For corners in

<u>BRANCH COUNTY</u>	Located In:	Corner Code #
GIRARD TWP		
1. Public Land Survey	T <u>5</u> S R <u>6</u> W	<u>G-2</u>
	T _____ R _____	_____
	T _____ R _____	_____
	T _____ R _____	_____
2. Property Controlling in Section	S _____ T _____ R _____	_____
	S _____	_____
	T _____ R _____	_____
3. Miscellaneous	S _____	_____
	T _____ R _____	_____
Property in Sec.	S _____	_____
	T _____ R _____	_____

STATE OF MICHIGAN  
Branch County  
Recorded

11-04-1998 15:47:28

Linda Lee Morrison-Mathews  
REGISTER OF DEEDS  
Register of Deeds Stamp & File Number

ACCEPTED BY THE BRANCH COUNTY  
SURVEY PEER GROUP AS THE OFFICIAL  
CORNER UNDER MICHIGAN PUBLIC ACT 345  
OF 1990 AT A MEETING HELD ON  
9-09-98

*E.R. Reed Co. Rep.*

**E.R. REED**

4. Lot No. \_\_\_\_\_, Recorded Plat \_\_\_\_\_  
5. Private Claims \_\_\_\_\_

I, EDWARD W. REED, in a field survey on AUGUST 29, 19 98 do hereby state that under requirements of P.A. 74, Michigan P.A. of 1970, the corner points mentioned in lines 1 and 2 above were in conformance with regulations and rules therefore as required in the current manual of survey instructions of the United States Department of the Interior, Bureau of Land Management or by a decree of a Court of Law and /or that the corner points mentioned in lines 3, 4 and 5 above were in conformance with the rules of the Michigan Board of Land Surveyors or by a Decree of a Court of Law; established, re-established, monumented, recovered, found as expressed below:

NOTE: Not more than 2 corners, all in the same town and range, may be recorded on this certificate.

QUARTER CORNER COMMON TO SECTIONS 3 & 4

A. Description of original monument and accessories and/or subsequent restoration:

- 1825: R. CLARK, JR, D.S. - CORNER SET
- 1971: E.R. REED, CO SURVEYOR - USING ALL AVAILABLE EXISTING LINE FENCES & C/L US 27, FOUND TWISTED IRON ROD 16" DEEP IN LINE WITH FENCE LINE RUNNING WEST AND CENTERLINE OF OLD ROAD, SET 1 1/2" X 30" PIPE, RECORDED IN LCRC # 00011
- 1973: D. BOONE, SURVEYOR - SURVEY TIED TO CORNER
- 1978: E.R. REED, CO SURVEYOR - SURVEY TIED TO CORNER

B. Description of corner evidence found and/or method applied in restoring or reestablishing corner:


FOUND 1 1/2" X 30" IRON PIPE AS DESCRIBED IN LCRC # 00011

C. Description of monument for corner and accessories established to perpetuate locating the position of the corner:

SET 1/2" X 18" REBAR IRON AND REMON CAP IN PLACE OF IRON PIPE, SET IN CLAMPED BOX

42" OAK	N 10 W	124.4'
1' SQUARE CONC. POST	WEST	44.50'
18" OAK	S 27 W	50.75'
P. POLE	S 34 E	82.40'

AND IS ACCEPTED AS THE BEST AVAILABLE EVIDENCE OF THE POSITION OF THE ORIGINAL CORNER.

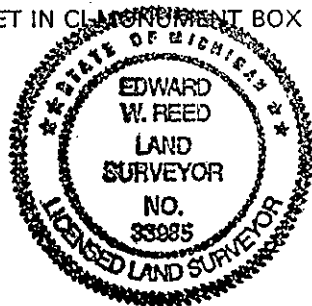

Signed by Edward W. Reed

Date SEPT. 9, 1998

EDWARD W, REED

Liber 00003 Page 0222

Surveyor's Michigan License No. 33985