

FEB 06 1999

SECTION  
1

**BRANCH COUNTY REMONUMENTATION PROGRAM  
LAND CORNER RECORDATION CERTIFICATE  
Filing Requirement of Act 74, Mich. P.A. 1970**

For corners in

<u>BRANCH COUNTY</u> GIRARDTWP	Located In:	Corner Code #
1. Public Land Survey	T <u>5</u> S R <u>6</u> W	<u>G-3</u>
	T _____ R _____	_____
	T _____ R _____	_____
	T _____ R _____	_____
2. Property Controlling in Section	S _____ T _____ R _____	_____
	S _____	_____
	T _____ R _____	_____
3. Miscellaneous	S _____	_____
	T _____ R _____	_____
Property in Sec.	S _____	_____
	T _____ R _____	_____

STATE OF MICHIGAN  
Branch County  
Recorded

12-07-1998 13:52:56

Linda Lee Morrison-Mathews  
REGISTER OF DEEDS

Register of Deeds Stamp & File Number

4. Lot No. \_\_\_\_\_, Recorded Plat \_\_\_\_\_  
5. Private Claims \_\_\_\_\_

Liber **00003** Page **0244**

I, EDWARD W. REED, in a field survey on OCTOBER 2, 19 98 do hereby state that under requirements of P.A. 74, Michigan P.A. of 1970, the corner points mentioned in lines 1 and 2 above were in conformance with regulations and rules therefore as required in the current manual of survey instructions of the United States Department of the Interior, Bureau of Land Management or by a decree of a Court of Law and /or that the corner points mentioned in lines 3, 4 and 5 above were in conformance with the rules of the Michigan Board of Land Surveyors or by a Decree of a Court of Law; established, re-established, monumented, recovered, found as expressed below:

**NOTE: Not more than 2 corners, all in the same town and range, may be recorded on this certificate.**

CORNER COMMON TO SECTIONS 3-4-9-10

A. Description of original monument and accessories and/or subsequent restoration:

- 1825: ROBERT CLARK, JR, DEPT. SURVEYOR - CORNER SET
- 1900: CHAS HAMILTON, CO SURVEYOR - FOUND STONE, PLACED GLASS & EARTHEN AROUND
- 1958: PLAT OF "LAKE SHORE HEIGHTS" TIED TO CORNER
- 1963: E.R. REED, CO. SURVEYOR - FOUND X IN PAVEMENT
- 1964: PLAT OF "HYANNIS HILLS" TIED TO CORNER
- 1971: WM. ROGERS, SURVEYOR - FOUND X IN PAVEMENT, RECORDED IN LCRC # 001
- 1994: E.W. REED, SURVEYOR - FOUND LARGE BOLT OVER CUT IN PAVEMENT

	A	B	C	D	E	F	G	H	I	J	K	L	M
1													
2	6		5		4		3		2		1		
3							●						
4	7		8		9		10		11		12		
5													
6	18		17		16		15		14		13		
7													
8	19		20		21		22		23		24		
9													
10	30		29		28		27		26		25		
11													
12	31		32		33		34		35		36		
13													

ACCEPTED BY THE BRANCH COUNTY SURVEY PEER GROUP AS THE OFFICIAL CORNER UNDER MICHIGAN PUBLIC ACT 345 OF 1990 AT A MEETING HELD ON 11-04-1998

E.R. Reed, Co. Rep.  
**E.R. REED**


B. Description of corner evidence found and/or method applied in restoring or reestablishing corner:

FOUND LARGE BOLT IN PAVEMENT FITTING OLD WITNESS OF E.R. REED, WM ROGERS, & E.W. REED

C. Description of monument for corner and accessories established to perpetuate locating the position of the corner:

SET 1/2" X 18" REBAR IRON WITH REMON CAP IN CI-MONUMENT BOX FLUSH WITH PAVED ROAD SURFACE

- |                             |          |                  |
|-----------------------------|----------|------------------|
| NW CORNER SCHOOL FOUNDATION | S45E     | 84.88'           |
| 10" MAPLE                   | S70W     | 69.12'           |
| 24" OAK                     | N37W     | 109.3' TO CENTER |
| 8" CHERRY                   | DUE WEST | 62.0' TO CENTER  |

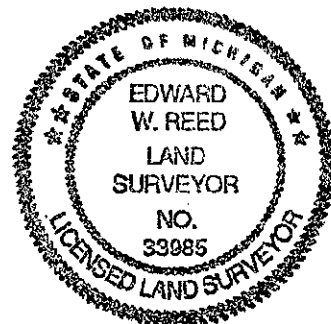

AND IS ACCEPTED AS A CAREFUL AND FAITHFUL PERPETUATION OF THE POSITION OF THE ORIGINAL CORNER.

Signed by Edward W. Reed Date NOV. 3, 1998

EDWARD W, REED

Surveyor's Michigan License No. 33985