

FEB 06 1999

SECTION

BRANCH COUNTY REMONUMATION PROGRAM
LAND CORNER RECORDATION CERTIFICATE
Filing Requirement of Act 74, Mich. P.A. 1970

Number 00003 Page 0245

For corners in

<u>BRANCH COUNTY</u> GIRARD TWP	Located In:	Corner Code #
1. Public Land Survey	T <u>5</u> S R <u>6</u> W	G-4
	T _____ R _____	_____
	T _____ R _____	_____
	T _____ R _____	_____
2. Property Controlling in Section	S _____ T _____ R _____	_____
	S _____	_____
	T _____ R _____	_____
3. Miscellaneous	S _____	_____
	T _____ R _____	_____
Property in Sec.	S _____	_____
	T _____ R _____	_____

STATE OF MICHIGAN
Branch County
Recorded

12-07-1998 13:53:03

Linda Lee Morrison-Mathews
REGISTER OF DEEDS

Register of Deeds Stamp & File Number

ACCEPTED BY THE BRANCH COUNTY
SURVEY PEER GROUP AS THE OFFICIAL
CORNER UNDER MICHIGAN PUBLIC ACT 345
OF 1990 AT A MEETING HELD ON
11-04-1998

E.R. Reed, Co. Rep.

E.R. REED

4. Lot No. _____, Recorded Plat _____
5. Private Claims _____

I, EDWARD W. REED, in a field survey on OCTOBER 2, 1998 do hereby state that under requirements of P.A. 74, Michigan P.A. of 1970, the corner points mentioned in lines 1 and 2 above were in conformance with regulations and rules therefore as required in the current manual of survey instructions of the United States Department of the Interior, Bureau of Land Management or by a decree of a Court of Law and /or that the corner points mentioned in lines 3, 4 and 5 above were in conformance with the rules of the Michigan Board of Land Surveyors or by a Decree of a Court of Law; established, re-established, monumented, recovered, found as expressed below:

	A	B	C	D	E	F	G	H	I	J	K	L	M
1													
2		6		5		4		3		2		1	
3													
4		7		8		9	●	10		11		12	
5													
6		18		17		16		15		14		13	
7													
8		19		20		21		22		23		24	
9													
10		30		29		28		27		26		25	
11													
12		31		32		33		34		35		36	
13													

NOTE: Not more than 2 corners, all in the same town and range, may be recorded on this certificate.

QUARTER CORNER COMMON TO SECTIONS 9 & 10

A. Description of original monument and accessories and/or subsequent restoration:

1825: ROBERT CLARK JR, DEPT SURVEYOR - CORNER SET
1900: CHAS. HAMILTON, CO SURVEYOR - FOUND IRON & BRICK
1971: WM ROGERS, SURVEYOR - PAINTED X IN PAVEMENT, WITNESSED, RECORDED IN LCRC 001


B. Description of corner evidence found and/or method applied in restoring or reestablishing corner:

FOUND IRON ROD FITTING WITNESS OF WM ROGERS, IN LCRC # 001

C. Description of monument for corner and accessories established to perpetuate locating the position of the corner:

SET 1/2" X 18" REBAR IRON WITH REMON CAP IN CI-MONUMENT BOX FLUSH WITH PAVED ROAD SURFACE

NW CORNER ANCHOR POST	EAST	50.69'
STANDARD OIL CO PIPE LINE MARKER	NE	66.64'
STANDARD OIL CO PIPE LINE MARKER	NW	63.38'
SW COR. BUILDING	N18E	185.50'
CENTER OF MONITORING WELL	N45W	66.35'
SE FENCE CORNER, STEEL POST	N42W	63.30'

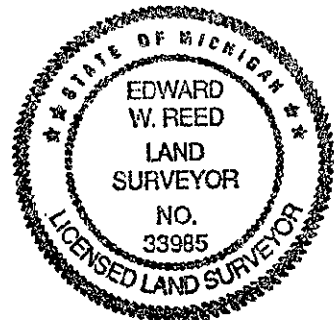

AND IS ACCEPTED AS A CAREFUL AND FAITHFUL PERPETUATION OF THE POSITION OF THE ORIGINAL CORNER.

Signed by *Edward W. Reed*
EDWARD W, REED

Date NOV. 4, 1998

Surveyor's Michigan License No. 33985