

SURVEY & REMONUMENTATION

MAR 21 1997

BRANCH COUNTY REMONUMENTATION CORNER LAND CORNER RECORDATION CERTIFICATE

Filing Requirement of Act 74, Mich. P.A. 1970

STATE OF MICHIGAN
Branch County
Recorded

For corners in **COMMISSION**

<u>BRANCH</u> (County)	Located In:	Corner Code #/	
GIRARD TWP.			
1. Public Land Survey	T <u>5</u> S R <u>6</u> W	<u>G-7</u>	
	T _____ R _____	_____	
	T _____ R _____	_____	
	T _____ R _____	_____	
2. Property Controlling in Section	S _____ T _____ R _____	_____	
	S _____ T _____ R _____	_____	
3. Miscellaneous Property in Sec.	S _____ T _____ R _____	_____	
	S _____ T _____ R _____	_____	

10-30-1996 09:20:34

Linda Lee Morrison-Mathews
REGISTER OF DEEDS

Liber **00003** Page **0079**

Register of Deeds Stamp & File Number

4. Lot No. _____, Recorded Plat _____
5. Private Claims _____


	A	B	C	D	E	F	G	H	I	J	K	L	M
2	8	5	4	3	2	1							
3													
4	7	6	9	10	11	12							
5													
6	18	17	16	15	14	13							
7													
8	19	20	21	22	23	24							
9													
10	30	29	28	27	26	25							
11													
12	31	32	33	34	35	36							
13													

I, EDWARD W. REED, in a field survey on SEPTEMBER 4, 1996, do hereby certify that under requirements of P.A. 74, Michigan P.A. of 1970, the corner points mentioned in lines 1 and 2 above were in conformance with regulations and rules therefore as required in the current manual of survey instructions of the United States Department of the Interior, Bureau of Land Management or by a decree of a Court of Law and/or that the corner points mentioned in lines 3, 4 and 5 above were in conformance with the rules of the Michigan Board of Land Surveyors or by a Decree of a Court of Law; established, re-established, monumented, re-monumented, recovered, found as expressed below:

NOTE: Not more than 4 corners, all in the same town and range, may be recorded on this certificate.

- A. Description of original monument and accessories and/or subsequent restoration:
 CORNER COMMON TO SECTIONS 15, 16, 21, & 22, T5S, R6W, GIRARD TWP., BRANCH COUNTY, MI
 1825: R. CLARK, JR., DEP. SURVEYOR, CORNER SET
 1868: A.R. DAY, SURVEYOR, PLAT OF "VILLAGE OF GIRARD" TIED TO CORNER
 1882: KNOWLES, SURVEYOR, "CENTER OF WELL SO SAYS MR. DAY SURVEYOR"
 M.S.H.D., CONSTRUCTION PLANS SHOW CORNER
 1974: E.R. REED, COUNTY SURVEYOR, IRON IN CAST IRON BOX, RECORDED IN L.C.R.C. #125

- B. Description of corner evidence found and/or method applied in restoring or reestablishing corner:
 FOUND CAPPED IRON STAKE & 1/2" IRON ALONG SIDE IN CAST IRON BOX, 6" BELOW ROAD SURFACE
 (NO LID ON BOX)
 RAISED TO ROAD SURFACE WITH RINGS AND CONCRETE
 PLACED REMONUMENTATION CAP ON 1/2" x 18" IRON
 REMOVED 2 OTHER IRONS

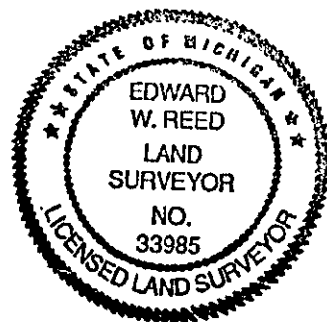

- C. Description of monument for corner and accessories established to perpetuate locating the position of the corner:
 S45W 51.2' TO NE CORNER OF STORE BLDG.
 S45E 83.2" TO NW CORNER OF HOUSE
 N45E 63.2' TO FACE OF TELEPHONE POLE
 N45W 77.0' TO SE CORNER OF BUILDING

ACCEPTED BY THE BRANCH COUNTY SURVEY PEER GROUP AS THE OFFICIAL CORNER UNDER MICHIGAN PUBLIC ACT 345 OF 1990 AT A MEETING HELD ON Oct. 7, 1996

E.R. Reed, Co. S.P.
E.R. REED

AND IS ACCEPTED AS A CAREFUL AND FAITHFUL PERPETUATION OF THE POSITION OF THE ORIGINAL CORNER.

Signed by *Edward W. Reed* Date SEPTEMBER 4, 1996
 Surveyor's Michigan License No. EDWARD W. REED 33985