

**SURVEY &
REMONUMENTATION**

MAR 13 1998

SECTION

**BRANCH COUNTY REMONUMENTATION CORNER
LAND CORNER RECORDATION CERTIFICATE
Filing Requirement of Act 74, Mich. P.A. 1970**

For corners in

<u>BRANCH</u> <small>(County)</small>	Located In:	Corner Code #
GIRARD TWP.		
1. Public Land Survey	<u>T 5 S R 6 W</u>	<u>G-9</u>
	T ___ R ___	_____
	T ___ R ___	_____
	T ___ R ___	_____
2. Property Controlling in Section	S ___ T ___ R ___	_____
	S ___ T ___ R ___	_____
3. Miscellaneous Property in Sec.	S ___ T ___ R ___	_____
	S ___ T ___ R ___	_____
4. Lot No. _____, Recorded Plat _____		
5. Private Claims _____		

STATE OF MICHIGAN
Branch County
Recorded

10-22-1997 09:56:37

Linda Lee Morrison-Matthews
REGISTER OF DEEDS

Register of Deeds Stamp & File Number

I, EDWARD W. REED, in a field survey on SEPTEMBER 3, 1997 do hereby state that under requirements of P.A. 74, Michigan P.A. of 1970, the corner points mentioned in lines 1 and 2 above were in conformance with regulations and rules therefore as required in the current manual of survey instructions of the United States Department of the Interior, Bureau of Land Management or by a decree of a Court of Law and /or that the corner points mentioned in lines 3, 4 and 5 above were in conformance with the rules of the Michigan Board of Land Surveyors or by a Decree of a Court of Law; established, re-established, monumented, recovered, found as expressed below:

NOTE: Not more than 2 corners, all in the same town and range, may be recorded on this certificate.

A. Description of original monument and accessories and/or subsequent restoration:

- 1825: R. CLARK jr. DEPT. SURVEYOR - CORNER SET
- 1916: L.M. SHUMAKER, DEPT. SURVEYOR - FOUND REDDISH STONE WELL SET IN BRICK.
- MICH. STATE HIGHWAY DEPT. - FOUND CORNER-SET MONUMENT BOX

ACCEPTED BY THE BRANCH COUNTY SURVEY PEER GROUP AS THE OFFICIAL CORNER UNDER MICHIGAN PUBLIC ACT 345 OF 1980 AT A MEETING HELD ON

9-10-97
E. A. Reed Co. Rep.
E.R. REED

B. Description of corner evidence found and/or method applied in restoring or reestablishing corner:

FOUND POINTED IRON IN CI-MONUMENT BOX IN OLD CONCRETE ROAD GRADE

C. Description of monument for corner and accessories established to perpetuate locating the position of the corner:


- SET REMON IRON ON IRON ROD, RAISED CI-MONUMENT BOX TO NEW ROAD GRADE WITH RINGS
- NAIL & WASHER S. SIDE TEL. POLE, N51W 61.24'
- NAIL & WASHER S. SIDE POWER POLE, N73E 92.34'
- NAIL & WASHER N. SIDE POWER POLE, S47E 70.31'
- NAIL & WASHER S. SIDE TEL. POLE, S70W 53.64'
- 4" STEEL ANCHOR POST N52W 62.85'
- ANGLE IRON FENCE CORNER POST, N57E 61.95'

AND IS ACCEPTED AS A CAREFUL AND FAITHFUL PERPETUATION OF THE POSITION OF THE ORIGINAL CORNER

Signed by Edward W. Reed
EDWARD W. REED

Date SEPTEMBER 3, 1997

Surveyor's Michigan License No. 33985

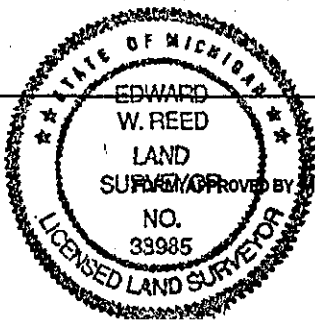

APPROVED BY MICHIGAN STATE BOARD OF PROFESSIONAL SURVEYORS, JAN. 28
REVISED MAY 14, 1975

REVISED JAN., 198
REVISED OCT., 199

