

SURVEY & REMONUMENTATION

FEB 08 1999

SECTION

**BRANCH COUNTY REMONUMENTATION PROGRAM
LAND CORNER RECORDATION CERTIFICATE
Filing Requirement of Act 74, Mich. P.A. 1970.**

For corners in

<u>BRANCH COUNTY</u>	Located in:	Corner Code #
GIRARD TWP		
1. Public Land Survey	T <u>5</u> S R <u>6</u> W	<u>H-3</u>
	T _____ R _____	_____
	T _____ R _____	_____
	T _____ R _____	_____
2. Property Controlling in Section	S _____ T _____ R _____	_____
	S _____	_____
	T _____ R _____	_____
3. Miscellaneous	S _____	_____
	T _____ R _____	_____
Property in Sec.	S _____	_____
	T _____ R _____	_____

STATE OF MICHIGAN
Branch County
Recorded

11-04-1998 15:47:35

Linda Lee Morrison-Mathews
REGISTER OF DEEDS

Register of Deeds Stamp & File Number

ACCEPTED BY THE BRANCH COUNTY
SURVEY PEER GROUP AS THE OFFICIAL
CORNER UNDER MICHIGAN PUBLIC ACT 311
OF 1989 AT A MEETING HELD ON
9-9-1998

E.R. Reed Co. Rep.
E.R. REED

4. Lot No. _____, Recorded Plat _____
5. Private Claims _____

I, EDWARD W. REED, in a field survey on JULY 14, 1998 do hereby state that under requirements of P.A. 74, Michigan P.A. of 1970, the corner points mentioned in lines 1 and 2 above were in conformance with regulations and rules therefore as required in the current manual of survey instructions of the United States Department of the Interior, Bureau of Land Management or by a decree of a Court of Law and /or that the corner points mentioned in lines 3, 4 and 5 above were in conformance with the rules of the Michigan Board of Land Surveyors or by a Decree of a Court of Law; established, re-established, monumented, recovered, found as expressed below:

NOTE: Not more than 2 corners, all in the same town and range, may be recorded on this certificate.

QUARTER CORNER COMMON TO SECTIONS 3 & 10

- A. Description of original monument and accessories and/or subsequent restoration:
1825: R. CLARK, JR., D.S. - CORNER SET
1868: A.R. DAY, D.S. - STONE
1900: CHAS. HAMILTON, CO. SURVEYOR - FOUND DAYS STONE & BRICK, ADDED EARTHEN AND GLASS
1963: E.R. REED, CO SURVEYOR - 1/4" IRON PIPE OVER STONE
1963: M.S.H.D. 1/2" PIPE 14" DEEP, RAISED TO SURFACE WITH 1" IRON PIPE
1971: WILLIAM ROGERS, SURVEYOR - 1" IRON PIPE, RECORDED IN LCRC # 00001

B. Description of corner evidence found and/or method applied in restoring or reestablishing corner:

FOUND 1" IRON PIPE FITTING WITNESS OF MSHD AND LCRC OF WILLIAM ROGERS

C. Description of monument for corner and accessories established to perpetuate locating the position of the corner:

SET 1/2" X 18" REBAR IRON WITH REMON CAP IN CI-MONUMENT BOX FLUSH WITH ROAD SURFACE

- 38" OAK S 45 W 37.7' TO CENTER
- 38' OAK S 61 W 47.6' TO CENTER
- 44" STUMP NORTH 32.2'
- 38" OAK S 83 W 91.4' TO CENTER
- C/L OF HERRICKSVILLE ROAD 0.8 FEET NORTH


AND IS ACCEPTED AS A CAREFUL AND FAITHFUL PERPETUATION OF THE POSITION OF THE ORIGINAL CORNER.

Signed by *Edward W. Reed*
EDWARD W, REED

Date 9-9-98

Surveyor's Michigan License No. 33985

Liber 00003 Page 0223

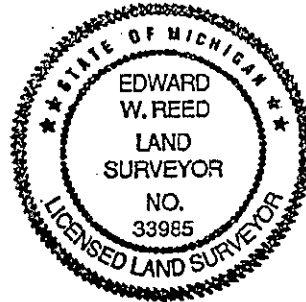

	A	B	C	D	E	F	G	H	I	J	K	L	M
1													
2	6		5		4			3		2		1	
3								●					
4	7		8		9			10		11		12	
5													
6	18		17		16			15		14		13	
7													
8	19		20		21			22		23		24	
9													
10	30		29		28			27		26		25	
11													
12	31		32		33			34		35		36	
13													