

**SURVEY & REMONUMENTATION**

FEB 08 1999

**SECTION**

**BRANCH COUNTY REMONUMENTATION PROGRAM  
LAND CORNER RECORDATION CERTIFICATE  
Filing Requirement of Act 74, Mich. P.A. 1970**

For corners in

<u>BRANCH COUNTY</u> GIRARD TWP.	Located In:	Corner Code #
1. Public Land Survey	T <u>5 S</u> R <u>6 W</u>	<u>I-3</u>
	T _____ R _____	_____
	T _____ R _____	_____
	T _____ R _____	_____
2. Property Controlling in Section	S _____ T _____ R _____	_____
	S _____	_____
	T _____ R _____	_____
3. Miscellaneous	S _____	_____
	T _____ R _____	_____
Property in Sec.	S _____	_____
	T _____ R _____	_____

STATE OF MICHIGAN  
Branch County  
Recorded

11-04-1998 15:47:41

Linda Lee Morrison-Mathews  
REGISTER OF DEEDS

Register of Deeds Stamp & File Number

ACCEPTED BY THE BRANCH COUNTY  
SURVEY PEER GROUP AS THE OFFICIAL  
CORNER UNDER MICHIGAN PUBLIC ACT 346  
OF 1990 AT A MEETING HELD ON

*E.R. Reed Co Rep.*  
**E.R. REED**

4. Lot No. \_\_\_\_\_, Recorded Plat \_\_\_\_\_  
5. Private Claims \_\_\_\_\_

I, EDWARD W. REED, in a field survey on AUG. 24, 1998 do hereby state that under requirements of P.A. 74, Michigan P.A. of 1970, the corner points mentioned in lines 1 and 2 above were in conformance with regulations and rules therefore as required in the current manual of survey instructions of the United States Department of the Interior, Bureau of Land Management or by a decree of a Court of Law and /or that the corner points mentioned in lines 3, 4 and 5 above were in conformance with the rules of the Michigan Board of Land Surveyors or by a Decree of a Court of Law; established, re-established, monumented, recovered, found as expressed below:

NOTE: Not more than 2 corners, all in the same town and range, may be recorded on this certificate.

CORNER COMMON TO SECTIONS 2, 3, 10 AND 11, GIRARD TOWNSHIP, BRANCH COUNTY, MICHIGAN

A. Description of original monument and accessories and/or subsequent restoration:

1825: ROBERT CLARK, JR., D.S., CORNER SET  
1900: SURVEY BY CHAS. HAMILTON, COUNTY SURVEYOR, FOUND STONE AND DEPOSIT BROKEN STONE PUMP  
1963: M. WALTER, SURVEY CHIEF, M.S.H.D., FOUND PIPE 18" DEEP, RAISED FLUSH WITH 1/2" IRON PIPE

B. Description of corner evidence found and/or method applied in restoring or reestablishing corner:

FOUND IRON PIPE AGREEING WITH WITNESS OF M.S.H. D.

C. Description of monument for corner and accessories established to perpetuate locating the position of the corner:

SET 1/2" X 18" REBAR IRON INSIDE OF IRON PIPE WITH REMONUMENTATION CAP  
SET C. I. MONUMENT BOX FLUSH WITH ROAD SURFACE

CENTER OF 36" MAPLE N 70 E 59.5'  
CENTER OF 14" MAPLE SOUTH 68.5'  
CENTER OF 40" MAPLE N 65 W 79.9'  
CENTER OF 8" FIR S 52 W 55.7'  
FENCE CORNER NORTH 33.74'  
CENTERLINE OF HERRICKSVILLE ROAD


AND IS ACCEPTED AS THE BEST AVAILABLE EVIDENCE OF THE POSITION OF THE ORIGINAL CORNER

Signed by *Edward W. Reed*  
EDWARD W. REED

Date SEPTEMBER 9, 1998

Surveyor's Michigan License No. 33985

Liber 00003 Page 0224

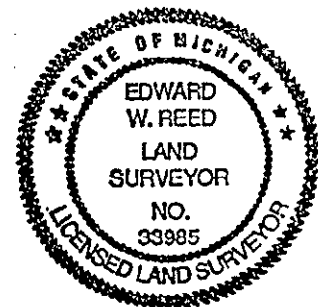

	A	B	C	D	E	F	G	H	I	J	K	L	M
1													
2	6		5		4		3		2		1		
3													
4	7		8		9		10		11		12		
5													
6	18		17		16		15		14		13		
7													
8	19		20		21		22		23		24		
9													
10	30		29		28		27		26		25		
11													
12	31		32		33		34		35		36		
13													