SURVEY &
REMONUMENTATION

FEB 13 2001

SECTION

BRANCH COUNTY REMONUMENTATION PROGRAM
LAND CORNER RECORDATION CERTIFICATE
Filing Requirement of Act 74, Mich. P.A. 1970

STATE OF MICHIGAN
Branch County
Recorded

12-15-2000 14:06:21

Linda Lee Morrison-Mathews
REGISTER OF DEEDS

Liber 00004 Page 0120

Register of Deeds Stamp & File Number

For corners in

BRANCH COUNTY
GIRARD TWP

	Located In:	Corner Code #
1. Public Land Survey	T 5 S R 6 W	J-9
	T___ R___	
	T___ R___	
	T___ R___	
2. Property Controlling in Section	S___ T___ R___	
	S___	
	T___ R___	
3. Miscellaneous	S___	
	T___ R___	
Property in Sec.	S___	
	T___ R___	

ACCEPTED BY THE BRANCH COUNTY SURVEY PEER GROUP AS THE OFFICIAL CORNER UNDER MICHIGAN PUBLIC ACT 345 OF 1990 AT A MEETING HELD ON 11-28-2000

E.R. Reed, P.S.
E.R. REED, Co. REP.

4. Lot No. _____, Recorded Plat _____

5. Private Claims _____

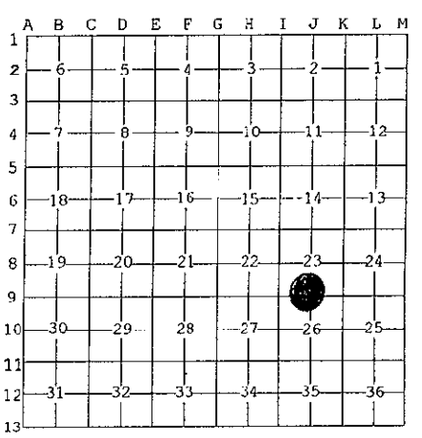

I, EDWARD W. REED, in a field survey on NOV. 3, 2000, do hereby state that under requirements of P.A. 74, Michigan P.A. of 1970, the corner points mentioned in lines 1 and 2 above were in conformance with regulations and rules therefore as required in the current manual of survey instructions of the United States Department of the Interior, Bureau of Land Management or by a decree of a Court of Law and /or that the corner points mentioned in lines 3, 4 and 5 above were in conformance with the rules of the Michigan Board of Land Surveyors or by a Decree of a Court of Law; established, re-established, monumented, recovered, found as expressed below:

NOTE: **Not more than 2 corners, all in the same town and range, may be recorded on this certificate.**

QUARTER CORNER COMMON TO SECTIONS 23 AND 26, GIRARD TOWNSHIP, BRANCH COUNTY, MICHIGAN.

A. Description of original monument and accessories and/or subsequent restoration:

1825: R. CLARK, JR.-CORNER SET
1963: MAX, WALTER-SURVEY CHIEF MSHD-1/2" PIPE IN INTERSECTION OF ROADS. (PRE-HIGHWAY CONSTRUCTION FOR I-69)

B. Description of corner evidence found and/or method applied in restoring or reestablishing corner:

POINT NOW FALLS IN RAISED ROAD AREA OF DAYBURG ROAD OVERPASS BRIDGE AND IS ABOUT 35' HIGHER THAN SURROUNDING GROUND
SET POINT ON LINE AND MIDWAY BETWEEN CORNERS EAST AND WEST
SET ½" X 18" REBAR IRON WITH CAP IN CAST IRON MONUMENT BOX FLUSH WITH ROAD SURFACE

C. Description of monument for corner and accessories established to perpetuate locating the position of the corner:

SET ½" X 18" REBAR IRON WITH CAP IN CAST IRON REMONUMENTATION BOX FLUSH WITH PAVED ROAD SURFACE

EAST END OF S. ALUMINUM RAIL OF CONCRETE GUARD RAIL OVER BRIDGE	S88W	313.54'
IN CENTERLINE OF E-W ROAD		
NAIL IN POWER POLE	N84E	271.58'
STEEL ANCHOR POST	N20W	84.78'

EDWARD W. REED
LAND SURVEYOR
NO. 33985
LICENSED LAND SURVEYOR

AND IS ACCEPTED AS A CAREFUL AND FAITHFUL REESTABLISHMENT OF THE POSITION OF THE ORIGINAL CORNER.

Signed by Edward W Reed

DATED: NOV. 3, 2000

EDWARD W. REED

Surveyor's Michigan License No. 33985

THIS COPY IS FOR BRANCH COUNTY DEPARTMENTAL MAPPING PURPOSES ONLY. THIS COPY NOT TO BE REPRODUCED SEND PUBLIC TO REGISTER OF DEEDS FOR COPIES.

FORM APPROVED BY MICHIGAN STATE BOARD OF PROFESSIONAL SURVEYORS. JAN. 28, 1971
REVISED MAY 14,1976
REVISED JAN., 1983
REVISED OCT., 1995