

SURVEY &  
REMONUMENTATION

FEB 06 1999

SECTION

STATE OF MICHIGAN  
BRANCH COUNTY  
BRANCH COUNTY  
RECORDED  
BRANCH COUNTY REMONUMENTATION PROGRAM  
LAND CORNER RECORDATION CERTIFICATE  
Filing Requirement of Act 74, Mich. P.A. 1970

12-07-1998 13:53:11

Linda Lee Morrison-Mathews  
REGISTER OF DEEDS

Liber 00003 Page 0246

Register of Deeds Stamp & File Number

For corners in

<u>BRANCH COUNTY</u>	Located in:	Corner Code #
GIRARD TWP		
1. Public Land Survey	T <u>5</u> S R <u>6</u> W	<u>K-03</u>
	T _____ R _____	_____
	T _____ R _____	_____
	T _____ R _____	_____
2. Property Controlling	S _____ T _____ R _____	_____
in Section	S _____	
	T _____ R _____	_____
3. Miscellaneous	S _____	
	T _____ R _____	_____
Property in Sec.	S _____	
	T _____ R _____	_____

ACCEPTED BY THE BRANCH COUNTY  
SURVEY PEER GROUP AS THE OFFICIAL  
CORNER UNDER MICHIGAN PUBLIC ACT 345  
OF 1990 AT A MEETING HELD ON  
11-02-1998

E.R. Reed, Co. Rep.

E.R. REED

4. Lot No. \_\_\_\_\_, Recorded Plat \_\_\_\_\_  
5. Private Claims \_\_\_\_\_

I, EDWARD W. REED, in a field survey on OCTOBER 30, 19 98 do hereby state that under requirements of P.A. 74, Michigan P.A. of 1970, the corner points mentioned in lines 1 and 2 above were in conformance with regulations and rules therefore as required in the current manual of survey instructions of the United States Department of the Interior, Bureau of Land Management or by a decree of a Court of Law and /or that the corner points mentioned in lines 3, 4 and 5 above were in conformance with the rules of the Michigan Board of Land Surveyors or by a Decree of a Court of Law; established, re-established, monumented, recovered, found as expressed below:

NOTE: Not more than 2 corners, all in the same town and range, may be recorded on this certificate.

CORNER COMMON TO SECTIONS 1-2-11-12

A. Description of original monument and accessories and/or subsequent restoration:

1825: ROBERT CLARK, JR. DEPT SURVEYOR - CORNER SET  
1865: A.R. DAY, SURVEYOR - STONE & BRICK  
1883: M. KNOWLES, SURVEYOR - STONE & BRICK

B. Description of corner evidence found and/or method applied in restoring or reestablishing corner:

PRORATED DISTANCE FROM KNOWLES SURVEY, DUG LARGE HOLE, DID NOT FIND STONE, FOUND PIECES OF BRICK, STONE MAY HAVE BEEN REMOVED DURING ROAD RECONSTRUCTION

C. Description of monument for corner and accessories established to perpetuate locating the position of the corner:

SET 1/2" X 18" REBAR IRON WITH REMON CAP IN CI-MONUMENT BOX FLUSH WITH PAVED ROAD SURFACE

SW CORNER TEL PED	N 57 W	51.97'
FACE OF 4" ROUND FENCE COR. POST	N 46 E	44.50'
NE CORNER TEL PED	S 35 W	63.10'
W. END ROAD CULVERT	N 12 W	130.8'

AND IS ACCEPTED AS THE BEST AVAILABLE EVIDENCE OF THE POSITION OF THE ORIGINAL CORNER.


Signed by

Edward W. Reed

EDWARD W, REED

Date NOV. 4, 1998

Surveyor's Michigan License No. 33985

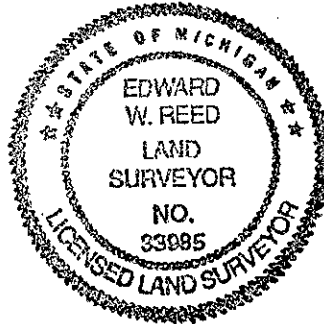

A	B	C	D	E	F	G	H	I	J	K	L	M
1												
2	6		5		4		3		2		1	
3												
4	7		8		9		10		11		12	
5												
6	18		17		16		15		14		13	
7												
8	19		20		21		22		23		24	
9												
10	30		29		28		27		26		25	
11												
12	31		32		33		34		35		36	
13												