

RE
 FEB 7 2000
 SECTION

**BRANCH COUNTY REMONUMATION PROGRAM
 LAND CORNER RECORDATION CERTIFICATE**
 Filing Requirement of Act 74, Mich. P.A. 1970

STATE OF MICHIGAN
 Branch County
 Recorded

11-08-1999 15:13:03

Linda Lee Morrison-Mathews
 REGISTER OF DEEDS

Liber 00004 Page 0021

Register of Deeds Stamp & File Number

For corners in

<u>BRANCH COUNTY</u>	Located In:	Corner Code #
GIRARD TWP		
1. Public Land Survey	T <u>5</u> S R <u>6</u> W	<u>L-11</u>
	T _____ R _____	_____
	T _____ R _____	_____
	T _____ R _____	_____
2. Property Controlling in Section	S _____ T _____ R _____	_____
	S _____	_____
	T _____ R _____	_____
3. Miscellaneous	S _____	_____
	T _____ R _____	_____
Property in Sec.	S _____	_____
	T _____ R _____	_____

4. Lot No. _____, Recorded Plat _____

5. Private Claims _____

I, EDWARD W. REED, in a field survey on SEPTEMBER 20, 19 99 do hereby state that under requirements of P.A. 74, Michigan P.A. of 1970, the corner points mentioned in lines 1 and 2 above were in conformance with regulations and rules therefore as required in the current manual of survey instructions of the United States Department of the Interior, Bureau of Land Management or by a decree of a Court of Law and /or that the corner points mentioned in lines 3, 4 and 5 above were in conformance with the rules of the Michigan Board of Land Surveyors or by a Decree of a Court of Law; established, re-established, monumented, recovered, found as expressed below:

NOTE: Not more than 2 corners, all in the same town and range, may be recorded on this certificate.

QUARTER COMMON TO SECTIONS 25 & 36, GIRARD TOWNSHIP

A. Description of original monument and accessories and/or subsequent restoration:

- 1825: ROBT. CLARK, JR., D.S., CORNER SET
- 1868: A. R. DAY, DEP. CO. SURVEYOR, REDDISH SAND STONE 15" LONG WITH BRICK AROUND
- 1901: CHARLES HAMILTON, COUNTY SURVEYOR, FOUND STONE WELL SET, FENCES AGREEING N&S

B. Description of corner evidence found and/or method applied in restoring or reestablishing corner:


FOUND POINTED STONE & BRICK IN LINE WITH FENCES NORTH & SOUTH

C. Description of monument for corner and accessories established to perpetuate locating the position of the corner:

REMOVED STONE, SET 1/2" X 18" REBAR IRON IN PLACE OF STONE WITH REMON CAP IN CI-MONUMENT BOX 4" BELOW GRAVEL ROAD SURFACE.

- WOOD ANCHOR POST, NORTH 32.40'
- TAG IN S. SIDE 36" MAPLE N65E 39.00'
- TAG IN W. SIDE 18" BOX ELDER SOUTH 38.50'
- TAG IN N. SIDE 4" ELM S49E 39.20'

ACCEPTED BY THE BRANCH COUNTY SURVEY PEER GROUP AS THE OFFICIAL CORNER UNDER MICHIGAN PUBLIC ACT 345 OF 1990 AT A MEETING HELD ON Oct. 6, 1999
E. R. Reed, Co. Rep.
 E. R. REED

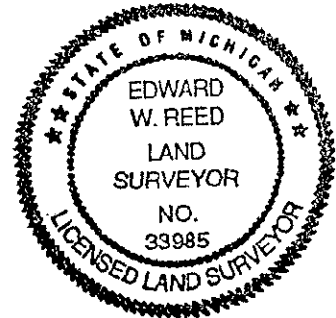

AND IS ACCEPTED AS A CAREFUL AND FAITHFUL PERPETUATION OF THE POSITION OF THE ORIGINAL CORNER.

Signed by Edward W. Reed

Date SEPTEMBER 20, 1999

EDWARD W. REED

Surveyor's Michigan License No. 33985