

FEB 02 2000

SECTION

BRANCH COUNTY REMONUMATION PROGRAM
LAND CORNER RECORDATION CERTIFICATE
Filing Requirement of Act 74, Mich. P.A. 1970

STATE OF MICHIGAN
Branch County
Recorded

11-08-1999 15:13:21

Linda Lee Morrison-Mathews
REGISTER OF DEEDS

Liber 00004 Page 0023

Register of Deeds Stamp & File Number

For corners in

BRANCH COUNTY	Located In:	Corner Code #
GIRARD TWP		
1. Public Land Survey	T 5 S R 6 W	M-3
	T _____ R _____	_____
	T _____ R _____	_____
	T _____ R _____	_____
2. Property Controlling in Section	S _____ T _____ R _____	_____
	S _____	_____
	T _____ R _____	_____
3. Miscellaneous	S _____	_____
	T _____ R _____	_____
Property in Sec.	S _____	_____
	T _____ R _____	_____

4. Lot No. _____, Recorded Plat _____

5. Private Claims _____

I, EDWARD W. REED, in a field survey on JULY 9, 19 99 do hereby state that under requirements of P.A. 74, Michigan P.A. of 1970, the corner points mentioned in lines 1 and 2 above were in conformance with regulations and rules therefore as required in the current manual of survey instructions of the United States Department of the Interior, Bureau of Land Management or by a decree of a Court of Law and /or that the corner points mentioned in lines 3, 4 and 5 above were in conformance with the rules of the Michigan Board of Land Surveyors or by a Decree of a Court of Law; established, re-established, monumented, recovered, found as expressed below:

NOTE: Not more than 2 corners, all in the same town and range, may be recorded on this certificate.

SOUTHEAST CORNER, SECTION 1 & NORTHEAST CORNER SECTION 12

A. Description of original monument and accessories and/or subsequent restoration:

1825: JOHN MULLETT, D.S., CORNER SET
1907: CHAS. HAMILTON, CO. SURVEYOR, FOUND OLD STAKES, PUT PLOW POINT AND DEPOSIT OF EARTHEN. GLO OFFSET OF 45 LINKS

B. Description of corner evidence found and/or method applied in restoring or reestablishing corner:

DUG LARGE HOLE 4' DEEP, NO REMAINS OF CORNER
SET CORNER @ GLO OFFSET OF 45 LINKS IN LINE WITH FENCE CORNER POST SOUTH
SET 1/2" X 18" REBAR WITH REMON CAP IN CAST IRON MONUMENT BOX IN SOUTH SHOULDER OF ROAD

C. Description of monument for corner and accessories established to perpetuate locating the position of the corner:

1/2" X 18" REBAR WITH REMON CAP IN CAST IRON MONUMENT BOX	
SOUTH 18.1	FENCE CORNER POST
NORTH 45 LINKS	BUTLER CORNER
N 31 W 56.16	FAP MARKER
S 70 W 53.0	SOUTH END ROAD CULVERT
S 60 W 24.15	TELEPHONE PEDESTAL (NE COR)
N 32 E 55.1	FACE ROUND WOOD ANCHOR POST
NORTH 14.2	CENTERLINE ROAD
S 52 E 19.58	TAG N SIDE 48" OAK

AND IS ACCEPTED AS THE BEST AVAILABLE EVIDENCE OF THE POSITION OF THE ORIGINAL CORNER.


Signed by Edward W. Reed

EDWARD W. REED

Surveyor's Michigan License No. 33985

Date JULY 9, 1999

ACCEPTED BY THE BRANCH COUNTY SURVEY PEER GROUP AS THE OFFICIAL CORNER UNDER MICHIGAN PUBLIC ACT 345 OF 1990 AT MEETING HELD ON 07/06/1999
E.R. Reed, Co. Rep.
E.R. REED

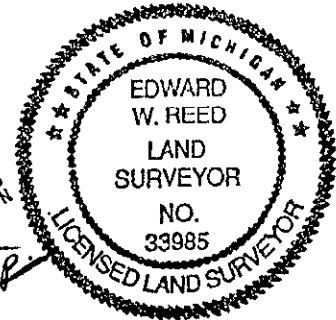

	A	B	C	D	E	F	G	H	I	J	K	L	M
1													
2	6		5		4		3		2		1		
3													
4	7		8		9		10		11		12		
5													
6	18		17		16		15		14		13		
7													
8	19		20		21		22		23		24		
9													
10	30		29		28		27		26		25		
11													
12	31		32		33		34		35		36		
13													