

SURVEY & REMONUMENTATION

FEB 0 8 1999

SECTION

**BRANCH COUNTY REMONUMATION PROGRAM
LAND CORNER RECORDATION CERTIFICATE
Filing Requirement of Act 74, Mich. P.A. 1970**

For corners in

<u>BRANCH COUNTY</u>	Located In:	Corner Code #
GIRARD TWP		
1. Public Land Survey	T <u>5</u> S R <u>6</u> W	<u>M-7</u>
	T ___ R ___	_____
	T ___ R ___	_____
	T ___ R ___	_____
2. Property Controlling in Section	S ___ T ___ R ___	_____
	S ___	_____
	T ___ R ___	_____
3. Miscellaneous	S ___	_____
	T ___ R ___	_____
Property in Sec.	S ___	_____
	T ___ R ___	_____

STATE OF MICHIGAN
Branch County
Recorded

11-04-1998 15:48:24

Linda Lee Morrison-Mathews
REGISTER OF DEEDS

Register of Deeds Stamp & File Number

ACCEPTED BY THE BRANCH COUNTY SURVEY PEER GROUP AS THE OFFICIAL CORNER UNDER MICHIGAN PUBLIC ACT 345 OF 1993 AT A MEETING HELD ON

E.R. Reed, Co. Rep.

E.R. REED

4. Lot No. _____, Recorded Plat _____

5. Private Claims _____

	A	B	C	D	E	F	G	H	I	J	K	L	M
1													
2	6		5		4		3		2		1		
3													
4	7		8		9		10		11		12		
5													
6	18		17		16		15		14		13		
7													
8	19		20		21		22		23		24		
9													
10	30		29		28		27		26		25		
11													
12	31		32		33		34		35		36		
13													

I, EDWARD W. REED, in a field survey on AUGUST 28, 1998 do hereby state that under requirements of P.A. 74, Michigan P.A. of 1970, the corner points mentioned in lines 1 and 2 above were in conformance with regulations and rules therefore as required in the current manual of survey instructions of the United States Department of the Interior, Bureau of Land Management or by a decree of a Court of Law and /or that the corner points mentioned in lines 3, 4 and 5 above were in conformance with the rules of the Michigan Board of Land Surveyors or by a Decree of a Court of Law; established, re-established, monumented, recovered, found as expressed below:

NOTE: Not more than 2 corners, all in the same town and range, may be recorded on this certificate.

SOUTHEAST CORNER SECTION 13
NORTHEAST CORNER SECTION 24

A. Description of original monument and accessories and/or subsequent restoration:

1825: R. CLARK JR., D.S. - CORNER SET, GLO OFFSET OF 26 LINKS TO BULTER TWP
OLD CORNER NOTES OF E.R. REED, CO SURVEYOR, - STONE, COR. FENCE POST, N 32'; COR FENCE POST, S. 33'
1978: E.R. REED, CO SURVEYOR - A-7, BUTLER TWP, RECORDED CORNER IN LCRC # 217


B. Description of corner evidence found and/or method applied in restoring or reestablishing corner:

DUG LARGE HOLE, FOUND NOTHING, RESET CORNER FROM GLO OFFSET AND OLD WITNESS

C. Description of monument for corner and accessories established to perpetuate locating the position of the corner:

SET 1/2" X 18" REBAR IRON ROD WITH REMON CAP IN CI-MONUMENT BOX FLUSH WITH PAVED ROAD SURFACE

CONC. POST NORTH 33.0 TO TOP CENTER
WOOD POST SOUTH 41.6' TO FACE
6" MAPLE S 15 E 36.2' TO CENTER
6.5' NORTH OF C/L OF GIRARD ROAD
17.16' NORTH OF A-7, BUTLER TWP.

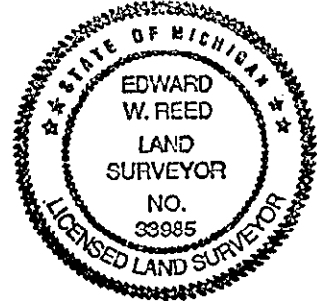

AND IS ACCEPTED AS A CAREFUL AND FAITHFUL REESTABLISHMENT OF THE POSITION OF THE ORIGINAL CORNER..

Signed by *Edward W. Reed*
EDWARD W, REED

Date SEPTEMBER 9, 1998

Liber 00003 Page 0230

Surveyor's Michigan License No. 33985