RE...

FEB 0 2 2000

SECTION

BRANCH COUNTY REMONUMATION PROGRAM
LAND CORNER RECORDATION CERTIFICATE
Filing Requirement of Act 74, Mich. P.A. 1970

STATE OF MICHIGAN
Branch County
Recorded

11-08-1999 15:13:30

Linda Lee Morrison-Mathews
REGISTER OF DEEDS

Liber 00004 Page 0024

Register of Deeds Stamp & File Number

For corners in

BRANCH COUNTY
GIRARD TWP

	Located In:	Corner Code #
1. Public Land Survey	T 5 S R 6 W	M-11
	T____ R____	
	T____ R____	
	T____ R____	
2. Property Controlling	S____ T____ R____	
in Section	S____	
	T____ R____	
3. Miscellaneous	S____	
	T____ R____	
Property in Sec.	S____	
	T____ R____	

4. Lot No. _____ , Recorded Plat _____

5. Private Claims _____

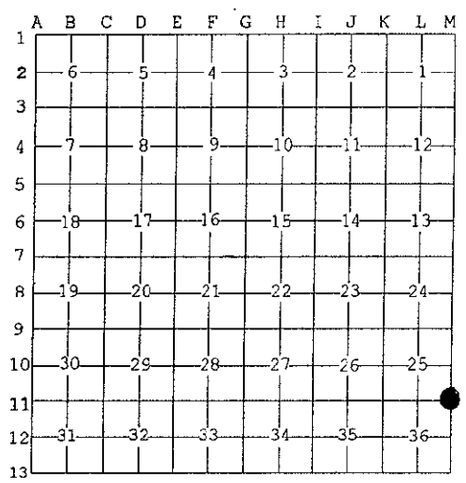

I, EDWARD W. REED, in a field survey on JULY 6, 19 99 do hereby state that under requirements of P.A. 74, Michigan P.A. of 1970, the corner points mentioned in lines 1 and 2 above were in conformance with regulations and rules therefore as required in the current manual of survey instructions of the United States Department of the Interior, Bureau of Land Management or by a decree of a Court of Law and /or that the corner points mentioned in lines 3, 4 and 5 above were in conformance with the rules of the Michigan Board of Land Surveyors or by a Decree of a Court of Law; established, re-established, monumented, recovered, found as expressed below:

NOTE: **Not more than 2 corners, all in the same town and range, may be recorded on this certificate.**

SE CORNER SECTION 25, NE CORNER SECTION 36, GIRARD TWP

A. Description of original monument and accessories and/or subsequent restoration:
1825: JOHN MALLET, D.S., CORNER SET
1825: ROBERT CLARK, JR., D.S., WITNESSES
1868: A.R. DAY, DEP. CO. SURVEYOR, FOUND REDDISH SAND STONE WITH BRICK
1937: E.L. MINER, COUNTY SURVEYOR, SURVEY, FOUND LARGE STONE WITH COBBLES, WELL SET, ADDED BRICKBATS, WITNESSED: CONC. ANCHOR POST N.W. 42.5; CONC. ANCHOR POST, NEARLY EAST 28.8'; FITTING EXACT INTERSECTION OF GRAVEL ROADS RUNNING N & W

B. Description of corner evidence found and/or method applied in restoring or reestablishing corner:
FOUND POINTED GRANITE STONE WITH WHOLE BRICK ON SOUTH SIDE & PIECES ON NORTH SIDE FITTING MINERS WITNESS OF TWO CONCRETE ANCHOR POSTS.

C. Description of monument for corner and accessories established to perpetuate locating the position of the corner:
SET ½" X 18" REBAR IRON WITH REMON CAP IN CI-MONUMENT BOX 4" BELOW GRAVEL ROAD SURFACE

N 40 W 42.34'	SE CORNER 3' SQUARE CONCRETE POST
N 85 E 28.35'	SW CORNER 3' SQUARE CONCRETE POST
S 70 W 71.48'	TAG NORTH SIDE POWER POLE
S 39 E 59.08'	TAG NORTH SIDE WOOD POST
N 50 E 38.15'	SW CORNER TELEPHONE PEDESTAL

STATE OF MICHIGAN
EDWARD W. REED
LAND SURVEYOR
NO. 33985
LICENSED LAND SURVEYOR

AND IS ACCEPTED AS A CAREFUL AND FAITHFUL PERPETUATION OF THE POSITION OF THE ORIGINAL CORNER.

Signed by Edward W. Reed Date JULY 6, 1999

EDWARD W. REED

Surveyor's Michigan License No. 33985

ACCEPTED BY THE BRANCH COUNTY SURVEY PEER GROUP AS THE OFFICIAL CORNER UNDER MICHIGAN PUBLIC ACT 345 OF 1990 AT A MEETING HELD ON Oct. 6, 1999

E.R. Reed, Co. Rep.
E.R. REED

FORM APPROVED BY MICHIGAN STATE BOARD OF PROFESSIONAL SURVEYORS, JAN. 28, 1971
REVISED MAY. 14,1976
REVISED JAN., 1983
REVISED OCT., 1995