

FEB 08 1999

SECTION

BRANCH COUNTY REMONUMENTATION  
LAND CORNER RECORDATION CERTIFICATE  
Filing Requirement of Act 74, Mich. P.A. 1970

For corners in

BRANCH	Located In:	Corner Code #
(County) UNOIN TOWNSHIP		
1. Public Land Survey	T <u>5S</u> R <u>7W</u>	<u>C-10</u>
	T _____ R _____	_____
	T _____ R _____	_____
	T _____ R _____	_____
2. Property Controlling in Section	S _____ T _____ R _____	_____
	S _____ T _____ R _____	_____
3. Miscellaneous Property in Sec.	S _____ T _____ R _____	_____
	S _____ T _____ R _____	_____

STATE OF MICHIGAN  
Branch County  
Recorded

12-07-1998 13:53:39

Linda Lee Morrison-Mathews  
REGISTER OF DEEDS

Liber 00003 Page 0249  
Register of Deeds Stamp & File Number

4. Lot No. \_\_\_\_\_, Recorded Plat \_\_\_\_\_  
5. Private Claims \_\_\_\_\_

I, ROBERT R. CARR, in a field survey on AUGUST 26, 1998 do hereby state that under requirements of P.A. 74, Michigan P.A. of 1970, the corner points mentioned in lines 1 and 2 above were in conformance with regulations and rules therefore as required in the current manual of survey instructions of the United States Department of the Interior, Bureau of Land Management or by a decree of a Court of Law and for that the corner points mentioned in lines 3, 4 and 5 above were in conformance with the rules of the Michigan Board of Land Surveyors or by a Decree of a Court of Law; established, re-established, monumented, recovered, found as expressed below:

NOTE: Not more than 2 corners, all in the same town and range, may be recorded on this certificate.

1/4 POST COMMON TO SECTIONS 29 & 30

A. Description of original monument and accessories and/or subsequent restoration:

ORIGINAL CORNER SET BY ROBERT CLARK, JR., D.S., 1826  
SURVEY BY E.L. MINER, COUNTY SURVEYOR 1938  
REESTABLISHED CORNER AT MID-POINT OF WEST LINE OF SECTION 29  
AND SET 4"X4"X4' CONCRETE POST IN BRICK BATS.  
BUHL'S TENANT HOUSE EASTERLY 63.3 FEET  
14 FEET SOUTH OF BUHL'S LINE FENCE RUNNING EAST  
9 FEET EAST OF CENTERLINE OF GRAVEL ROAD

	A	B	C	D	E	F	G	H	I	J	K	L	M
1													
2		6		5		4		3		2		1	
3													
4		7		8		9		10		11		12	
5													
6		18		17		16		15		14		13	
7													
8		19		20		21		22		23		24	
9													
10		30		29		28		27		26		25	
11													
12		31		32		33		34		35		36	
13													

ACCEPTED BY THE BRANCH COUNTY SURVEY PEER GROUP AS THE OFFICIAL CORNER UNDER MICHIGAN PUBLIC ACT 345 OF 1990 AT A MEETING HELD ON 11-04-98


E.R. Reed Co. Rep.  
E.R. REED

B. Description of corner evidence found and/or method applied in restoring or reestablishing corner:

MEASURED 14 FEET SOUTH OF TREE ROW OCCUPATION RUNNING EAST AND 9' EAST OF CENTERLINE OF ROAD AND DUG. FOUND 4"X4"X4' CONCRETE POST LEANING BAD TO EAST BUT BOTTOM 1 FOOT STRAIGHT WITH BRICK AROUND. MEASURED S80°E 62.30 FEET TO NW CORNER OF STONE FOUNDATION OF HOUSE (MINER - 63.3)  
LEFT BOTTOM OF 4"X4" CONCRETE POST IN PLACE AND PLACED 1/2" IRON WITH REMONUMENTATION CAP OVER AT 1 FOOT, MORE OR LESS, DEEP WITH MONUMENT BOX OVER 0.5 FEET BELOW GRAVEL SURFACE.

C. Description of monument for corner and accessories established to perpetuate locating the position of the corner:

1/2" IRON WITH BRANCH COUNTY REMONUMENTATION CAP IN MONUMENT BOX 0.5' BELOW GRAVEL SURFACE.  
NW CORNER OF HOUSE, S80°E 62.30 FEET, TO STONE FOUNDATION.  
ANGLE IRON CORNER POST, N36° W 66.11 FEET, MEASURED AT GROUND.  
20" MAPLE, N53°W 44.68 FEET, SET SPOTTER ON NORTHERLY SIDE IN ROOTS.  
24" MAPLE, S57°W 48.43 FEET, SET SPOTTER ON NORTHERLY SIDE IN ROOTS.  
TWIN 14" MAPLE, S22°E 50.28 FEET, SET SPOTTER ON WESTERLY SIDE IN ROOTS.  
14 FEET, MORE OR LESS, SOUTH OF TREE ROW TO EAST.  
9 FEET, MORE OR LESS, EAST OF CENTERLINE OF NORTH AND SOUTH ROAD.  
IN CENTERLINE OF GRAVEL DRIVE TO HOUSE EAST.

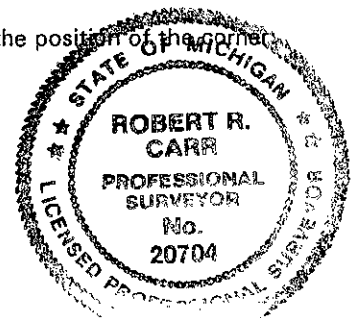

AND IS ACCEPTED AS A CAREFUL AND FAITHFUL REESTABLISHMENT OF THE POSITION OF THE ORIGINAL CORNER.

Signed by Robert R. Carr  
Surveyor's Michigan License No. 20704

Date OCT 1, 1998