

FEB 1 2000

SECTION

BRANCH COUNTY REMONUMENTATION CORNER  
LAND CORNER RECORDATION CERTIFICATE  
Filing Requirement of Act 74, Mich. P.A. 1970

STATE OF MICHIGAN  
Branch County  
Recorded

For corners in

<u>BRANCH</u>	Located In:	Corner Code #
(County)		
UNION TOWNSHIP		
1. Public Land Survey	T <u>5S</u> R <u>7W</u>	<u>C-13</u>
	T _____ R _____	_____
	T _____ R _____	_____
	T _____ R _____	_____
2. Property Controlling in Section	S _____ T _____ R _____	_____
	S _____ T _____ R _____	_____
3. Miscellaneous	S _____ T _____ R _____	_____
Property in Sec.	S _____ T _____ R _____	_____
4. Lot No. _____, Recorded Plat _____		
5. Private Claims _____		

12-30-1999 11:01:39

Linda Lee Morrison-Mathews  
REGISTER OF DEEDS

Liber **00004** Page **0054**

Register of Deeds Stamp & File Number

I, ROBERT R. CARR, in a field survey on NOVEMBER 1, 19 99 do hereby state that under requirements of P.A. 74, Michigan P.A. of 1970, the corner points mentioned in lines 1 and 2 above were in conformance with regulations and rules therefore as required in the current manual of survey instructions of the United States Department of the Interior, Bureau of Land Management or by a decree of a Court of Law and /or that the corner points mentioned in lines 3, 4 and 5 above were in conformance with the rules of the Michigan Board of Land Surveyors or by a Decree of a Court of Law; established, re-established, monumented, recovered, found as expressed below:

NOTE: Not more than 2 corners, all in the same town and range, may be recorded on this certificate.

A. Description of original monument and accessories and/or subsequent restoration:

ORIGINAL CORNER SET BY JOHN MULLET, D.S. 1825  
SURVEY BY M. KNOWLES, COUNTY SURVEYOR, (NO DATE) CALLS FOR SLEIGHSHOE

	A	B	C	D	E	F	G	H	I	J	K	L	M
1													
2	6		5		4		3		2		1		
3													
4	7		8		9		10		11		12		
5													
6	18		17		16		15		14		13		
7													
8	19		20		21		22		23		24		
9													
10	30		29		28		27		26		25		
11													
12	31		32		33		34		35		36		
13													

ACCEPTED BY THE BRANCH COUNTY SURVEY PEER GROUP AS THE OFFICIAL CORNER UNDER MICHIGAN PUBLIC ACT 345 OF 1990 AT A MEETING HELD ON 12-07-1999

E.R. Reed, P.S.  
E.T. REED


B. Description of corner evidence found and/or method applied in restoring or reestablishing corner:

FOUND NW CORNER OF SECTION 5, BATAVIA TOWNSHIP PER I.D. MINER, COUNTY SURVEYOR, 1891 (1/2" IRON WITH OX SHOE AND BRICK)  
MEASURED WEST G.L.O. JOG OF 197.34 FEET. THIS LOCATION FALLS 3 FEET WEST OF WEST EDGE OF BITUMINOUS PAVEMENT. DUG BUT FOUND NO EVIDENCE OF SLEIGHSHOE. CORNER APPEARS TO HAVE BEEN OBLITERATED WITH ROAD CONSTRUCTION. RESET CORNER AT G.L.O. JOG OF 197.34 FEET ON PROJECTION OF TOWNLINER WEST FROM S 1/4 CORNER OF SECTION 32, T5S, R7W TROUGH NW CORNER OF SECTION 5, T6S, R7W.

THIS LOCATION ACCEPTED AS BEST AVAILABLE EVIDENCE OF ORIGINAL CORNER.

C. Description of monument for corner and accessories established to perpetuate locating the position of the corner:

BRANCH COUNTY REMONUMENTATION STAKE AND CAP IN MONUMENT BOX  
0.5 FEET BELOW SURFACE OF GRAVEL SHOULDER SURROUNDED WITH ROCKS  
8" ASH, S44°W 21.51 FEET, SET NAIL AND SPOTTER  
SE CORNER OF POLE BARN, N56°W 43.32 FEET  
NE CORNER OF POLE BARN, N20°W 92.05 FEET  
TWIN 18" ASH, N37°E 62.93 FEET, SET NAIL AND SPOTTER.

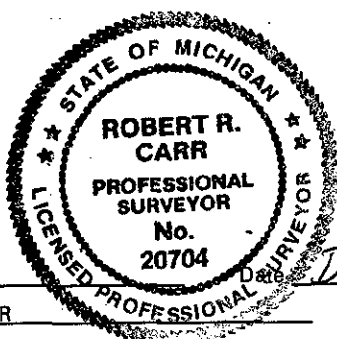

Signed by [Signature]  
Surveyor's Michigan License No. 20704 ROBERT R. CARR

DEC. 7, 1999