

SURVEY & REMONUMENTATION

MAR 13 1998

SECTION

**BRANCH COUNTY REMONUMATION CORNER
LAND CORNER RECORDATION CERTIFICATE
Filing Requirement of Act 74, Mich. P.A. 1970**

For corners in

<u>BRANCH COUNTY</u> UNION TWP	Located In:	Corner Code #
1. Public Land Survey	T <u>5</u> S. R <u>7W</u>	<u>D-7</u>
	T <u> </u> R <u> </u>	<u> </u>
	T <u> </u> R <u> </u>	<u> </u>
	T <u> </u> R <u> </u>	<u> </u>
2. Property Controlling in Section	S <u> </u> T <u> </u> R <u> </u>	<u> </u>
	S <u> </u> T <u> </u> R <u> </u>	<u> </u>
3. Miscellaneous Property in Sec.	S <u> </u> T <u> </u> R <u> </u>	<u> </u>
	S <u> </u> T <u> </u> R <u> </u>	<u> </u>

STATE OF MICHIGAN
Branch County
Recorded

12-30-1997 10:06:02

Linda Lee Morrison-Mathews
REGISTER OF DEEDS

Liber **000003** Page **0197**

Register of Deeds Stamp & File Number

4. Lot No. _____, Recorded Plat _____
5. Private Claims _____

I, EDWARD W. REED, in a field survey on DECEMBER 3, 1997 do hereby state that under requirements of P.A. 74, Michigan P.A. of 1970, the corner points mentioned in lines 1 and 2 above were in conformance with regulations and rules therefore as required in the current manual of survey instructions of the United States Department of the Interior, Bureau of Land Management or by a decree of a Court of Law and /or that the corner points mentioned in lines 3, 4 and 5 above were in conformance with the rules of the Michigan Board of Land Surveyors or by a Decree of a Court of Law; established, re-established, monumented, recovered, found as expressed below:

	A	B	C	D	E	F	G	H	I	J	K	L	M
1													
2		6		5		4		3		2		1	
3													
4		7		8		9		10		11		12	
5													
6		18		17		16		15		14		13	
7													
8		19		20		21		22		23		24	
9													
10		30		29		28		27		26		25	
11													
12		31		32		33		34		35		36	
13													

NOTE: Not more than 2 corners, all in the same town and range, may be recorded on this certificate.

QUARTER CORNER COMMON TO SECTIONS 17 & 20

A. Description of original monument and accessories and/or subsequent restoration:

- 1826: R.CLARK, JR, DEPT SURVEYOR - CORNER SET
 - 1898: I.D. MINER, CO. SURVEYOR - FOUND PIG IRON STAKE, SET TWO INK BOTTLES BESIDE IT
 - 1984: E.R. REED, CO. SURVEYOR - FOUND PIG IRON, SET 1/2" X 16" REBAR IRON WITH RLS CAP OVER BAR.
- RECORDED IN LCRC # II-0067

B. Description of corner evidence found and/or method applied in restoring or reestablishing corner


FOUND 1/2" IRON ROD IN CI-MONUMENT BOX.
SET REMON CAP ON IRON

ACCEPTED BY THE BRANCH COUNTY SURVEY PEER GROUP AS THE OFFICIAL CORNER UNDER MICHIGAN PUBLIC ACT 345 OF 1990 AT A MEETING HELD ON
12-08-97

E.R. Reed
E.R. REED

C. Description of monument for corner and accessories established to perpetuate locating the position of the corner:

- 1/2" IRON ROD IN CI-MONUMENT BOX.
- 3.4' S. OF C/L OF BLACKTOP PVMT.
- RR TIE-POST, NORTH 35.1' TO FACE
- RR TIE POST, NORTH 42.6' TO FACE
- C/L OF W. END OF CMP DRIVE CULVERT, N 5 E 22.7'
- C/L OF E. END OF CMP DRIVE CULVERT, N 45 E 38.4'
- C/L OF DITCH, DUE EAST 182.0'
- FACE OF POWER POLE, N 55 E 164.8

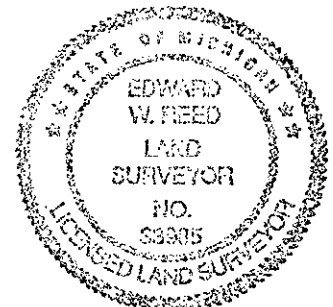

AND IS ACCEPTED AS A CAREFUL AND FAITHFUL PERPETUATION OF THE POSITION OF THE ORIGINAL CORNER

Signed by Edward W. Reed
EDWARD W. REED

Date DECEMBER 3, 1997

Surveyor's Michigan License No. 33985