

FEB 03 2000

SECTION

BRANCH COUNTY REMONUMENTATION CORNER  
LAND CORNER RECORDATION CERTIFICATE STATE OF MICHIGAN  
Filing Requirement of Act 74, Mich. P.A. 1970 Branch County  
Recorded

For corners in

<u>BRANCH</u>	Located In:	Corner Code #
(County)		
UNION TOWNSHIP		
1. Public Land Survey	T <u>5S</u> R <u>7W</u>	<u>D-13</u>
	T _____ R _____	_____
	T _____ R _____	_____
	T _____ R _____	_____
2. Property Controlling in Section	S _____ T _____ R _____	_____
	S _____ T _____ R _____	_____
3. Miscellaneous Property in Sec.	S _____ T _____ R _____	_____
	S _____ T _____ R _____	_____

12-30-1999 11:01:46

Linda Lee Morrison-Mathews  
REGISTER OF DEEDS

Liber **00004** Page **0055**

Register of Deeds Stamp & File Number

4. Lot No. \_\_\_\_\_, Recorded Plat \_\_\_\_\_  
5. Private Claims \_\_\_\_\_

I, ROBERT R. CARR, in a field survey on NOVEMBER 1, 1999 do hereby state that under requirements of P.A. 74, Michigan P.A. of 1970, the corner points mentioned in lines 1 and 2 above were in conformance with regulations and rules therefore as required in the current manual of survey instructions of the United States Department of the Interior, Bureau of Land Management or by a decree of a Court of Law and /or that the corner points mentioned in lines 3, 4 and 5 above were in conformance with the rules of the Michigan Board of Land Surveyors or by a Decree of a Court of Law; established, re-established, monumented, recovered, found as expressed below:

NOTE: Not more than 2 corners, all in the same town and range, may be recorded on this certificate.

A. Description of original monument and accessories and/or subsequent restoration:

ORIGINAL CORNER SET BY JOHN MULLETT, D.S. 1825  
M. KNOWLES, DEP. CO. SURVEYOR (NO DATE) STONE 20 AND STONES  
C. HAMILTON, CO. SURVEYOR. (NO DATE) FOUND KNOWLES CORNER

1	A	B	C	D	E	F	G	H	I	J	K	L	M
2		6		5		4		3		2		1	
3													
4		7		8		9		10		11		12	
5													
6		18		17		16		15		14		13	
7													
8		19		20		21		22		23		24	
9													
10		30		29		28		27		26		25	
11													
12		31		32		33		34		35		36	
13													

ACCEPTED BY THE BRANCH COUNTY SURVEY PEER GROUP AS THE OFFICIAL CORNER UNDER MICHIGAN PUBLIC ACT 345 OF 1990 AT A MEETING HELD ON 12-07-99

E.R. Reed, P.S.  
E.P. REED


B. Description of corner evidence found and/or method applied in restoring or reestablishing corner:

MEASURED G.L.O. JOG OF 133.65 FEET WEST FROM FOUND N 1/4 CORNER OF SECTION 5, T6S, R7W AND DUG AND FOUND OLD CONCRETE, STONES AND SHEET METAL (FARMER SAID A CULVERT RAN THROUGH THIS AREA). A TREE ROW RUNS NORTH. CORNER APPEARS TO HAVE BEEN OBLITERATED BY CONSTRUCTION. RESET CORNER AT AVERAGE G.L.O. JOG OF 133.65 FEET BY PROJECTING TOWN LINE WEST FROM FOUND SE CORNER OF SECTION 32, THROUGH FOUND N 1/4 CORNER OF SECTION 5, T6S, R7W.

THIS LOCATION ACCEPTED AS BEST AVAILABLE EVIDENCE OF ORIGINAL CORNER.

C. Description of monument for corner and accessories established to perpetuate locating the position of the corner:

BRANCH COUNTY REMONUMENTATION STAKE AND CAP IN MONUMENT BOX.  
FELL ON WEST EDGE OF CONCRETE WALL (BELOW GRADE)  
20" ASH, N65°W 93.10 FEET, SET NAIL AND SPOTTER  
14" ASH, N20°E 37.26 FEET, SET NAIL AND SPOTTER  
8" ASH, N08°W 62.60 FEET, SET NAIL AND SPOTTER  
48" MAPLE, N58°E 71.30 FEET, SET NAIL AND SPOTTER  
CENTERLINE OF DITCH NORTHWEST 5 FEET.

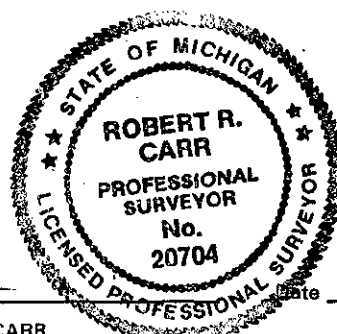

Signed by [Signature]  
Surveyor's Michigan License No. 20704 ROBERT R. CARR

Date DEC. 7, 1999