

**SURVEY &
REMONUMENTATION**

MAR 13 1998

SECTION

**BRANCH COUNTY REMONUMATION CORNER
LAND CORNER RECORDATION CERTIFICATE
Filing Requirement of Act 74, Mich. P.A. 1970**

For corners in

<u>BRANCH COUNTY</u> UNION TWP	Located In:	Corner Code #
1. Public Land Survey	T <u>5</u> S R <u>7</u> W	<u>F-9</u>
	T _____ R _____	_____
	T _____ R _____	_____
	T _____ R _____	_____
2. Property Controlling in Section	S _____ T _____ R _____	_____
	S _____	_____
	T _____ R _____	_____
3. Miscellaneous	S _____	_____
	T _____ R _____	_____
Property in Sec.	S _____	_____
	T _____ R _____	_____

STATE OF MICHIGAN
Branch County
Recorded

12-30-1997 10:06:17

Linda Lee Morrison-Mathews
REGISTER OF DEEDS

Liber **00003** Page **0199**

Register of Deeds Stamp & File Number

4. Lot No. _____, Recorded Plat _____

5. Private Claims _____

I, EDWARD W. REED, in a field survey on DECEMBER 3, 1997 do hereby state that under requirements of P.A. 74, Michigan P.A. of 1970, the corner points mentioned in lines 1 and 2 above were in conformance with regulations and rules therefore as required in the current manual of survey instructions of the United States Department of the Interior, Bureau of Land Management or by a decree of a Court of Law and for that the corner points mentioned in lines 3, 4 and 5 above were in conformance with the rules of the Michigan Board of Land Surveyors or by a Decree of a Court of Law; established, re-established, monumented, recovered, found as expressed below:

NOTE: Not more than 2 corners, all in the same town and range, may be recorded on this certificate.

A	B	C	D	E	F	G	H	I	J	K	L	M
1												
2	6		5		4		3		2		1	
3												
4	7		8		9		10		11		12	
5												
6	18		17		16		15		14		13	
7												
8	19		20		21		22		23		24	
9												
10	30		29		28		27		26		25	
11												
12	31		32		33		34		35		36	
13												

QUARTER CORNER COMMON TO SECTIONS 21-28

A. Description of original monument and accessories and/or subsequent restoration:

- 1826: R. CLARK, JR., SURVEYOR - CORNER SET
- 1901: HAMILTON, SURVEYOR - PLOW POINT
- 1991: D. ANDREWS, SURVEYOR - FOUND PLOW POINT DOWN 3' SET BAR AND CAP IN MON BOX, RECORDED LCRC # II-0170

B. Description of corner evidence found and/or method applied in restoring or reestablishing corner:


FOUND 1/2" IRON BAR WITH ANDREWS CAP, SET 1/2" X 18" REBAR IRON WITH REMON CAP

C. Description of monument for corner and accessories established to perpetuate locating the position of the corner:

1/2" IRON ROD IN CI-MONUMENT BOX

- ANCHOR POST, N 46 E 36.73'
- 24" TREE, S 84 E 28.87'
- 24" WILLOW, S 26 E 52.20'
- TEL. PED, N 46 W 39.50'
- S. END ROAD CULVERT, S 45 W 32.9'

ACCEPTED BY THE BRANCH COUNTY
SURVEY PEER GROUP AS THE OFFICIAL
CORNER UNDER MICHIGAN PUBLIC ACT 345
OF 1990 AT A MEETING HELD ON
12-08-97
E. R. Reed
E. R. REED

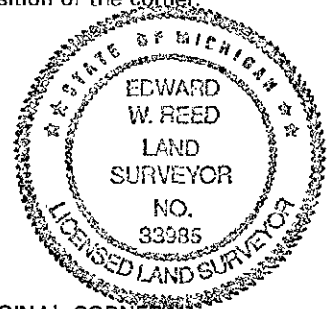

AND IS ACCEPTED AS A CAREFUL AND FAITHFUL PERPETUATION OF THE POSITION OF THE ORIGINAL CORNER

Signed by Edward W. Reed
EDWARD W. REED

Date 12/03/97

Surveyor's Michigan License No. 33985