

**SURVEY &
REMONUMENTATION**

MAR 13 1998

SECTION

**BRANCH COUNTY REMONUMATION CORNER
LAND CORNER RECORDATION CERTIFICATE
Filing Requirement of Act 74, Mich. P.A. 1970**

For corners in

<u>BRANCH COUNTY</u> UNION TWP.	Located In:	Corner Code #
1. Public Land Survey	T <u>5</u> S R <u>7</u> W	<u>G-7</u>
	T ___ R ___	_____
	T ___ R ___	_____
	T ___ R ___	_____
2. Property Controlling in Section	S ___ T ___ R ___	_____
	S ___ T ___ R ___	_____
3. Miscellaneous Property in Sec.	S ___ T ___ R ___	_____
	S ___ T ___ R ___	_____

STATE OF MICHIGAN
Branch County
Recorded

12-30-1997 10:06:32

Linda Lee Morrison-Mathews
REGISTER OF DEEDS

Liber **00003** Page **0201**

Register of Deeds Stamp & File Number

4. Lot No. _____, Recorded Plat _____
5. Private Claims _____

I, EDWARD W. REED, in a field survey on DECEMBER 3, 1997 do hereby state that under requirements of P.A. 74, Michigan P.A. of 1970, the corner points mentioned in lines 1 and 2 above were in conformance with regulations and rules therefore as required in the current manual of survey instructions of the United States Department of the Interior, Bureau of Land Management or by a decree of a Court of Law and /or that the corner points mentioned in lines 3, 4 and 5 above were in conformance with the rules of the Michigan Board of Land Surveyors or by a Decree of a Court of Law; established, re-established, monumented, recovered, found as expressed below:

A	B	C	D	E	F	G	H	I	J	K	L	M
1												
2	6	5	4	3	2	1						
3												
4	7	8	9	10	11	12						
5												
6	18	17	16	15	14	13						
7												
8	19	20	21	22	23	24						
9												
10	30	29	28	27	26	25						
11												
12	31	32	33	34	35	36						
13												

NOTE: Not more than 2 corners, all in the same town and range, may be recorded on this certificate.

CORNER COMMON TO SECTIONS 15-16-21-22

A. Description of original monument and accessories and/or subsequent restoration:

- 1826: R. CLARK, JR., DEPT SURVEYOR - SET CORNER
- 1900: C. HAMILTON, SURVEYOR - FOUND STONE AND BRICK
- 1901: COX, SURVEYOR - STONE AND BRICK
- 1991: D. ANDREWS, SURVEYOR - DUG 4' X 7' X 2' HOLE, G-8 WAS AT MIDPOINT PER BK. 1, PG 246. AFTER RE-ESTABLISHING G-8, I THEN EXTENDED LINE PER RECORD NORTH AND RE-ESTABLISHED CORNER. RECORDED IN LCRC # II-0168

B. Description of corner evidence found and/or method applied in restoring or reestablishing corner:

FOUND IRON ROD IN CI-MONUMENT BOX FITTING WITNESS OF LCRC # II-0168
SET REMON CAP OVER IRON ROD


C. Description of monument for corner and accessories established to perpetuate locating the position of the corner:

1/2" IRON ROD IN CI-MONUMENT BOX

- 24" OAK, S 20 W 28.94'
- 12" OAK, S 30 E 34.39'
- 36" OAK, S 65 E 74.28'
- 4" OAK, N 80 E 118.8' TO CENTER

ACCEPTED BY THE BRANCH COUNTY
SURVEY PEER GROUP AS THE OFFICIAL
CORNER UNDER MICHIGAN PUBLIC ACT 345
OF 1990 AT A MEETING HELD ON
12-08-97

E.R. Reed
E.R. REED

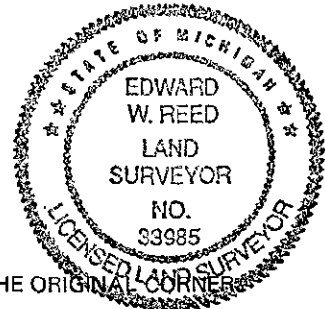

AND IS ACCEPTED AS A CAREFUL AND FAITHFUL PERPETUATION OF THE POSITION OF THE ORIGINAL CORNER

Signed by *Edward W. Reed*
EDWARD W. REED

Date DECEMBER 3, 1997

Surveyor's Michigan License No. 33985