

REMONUMENTATION

APR 26 1995

ACCEPTED BY THE BRANCH COUNTY SURVEY PEER GROUP AS THE OFFICIAL CORNER UNDER MICHIGAN PUBLIC ACT 345 OF 1990 AT A MEETING HELD ON 12-16-94

E. R. Reed Co. Rep.

COMMISSION BRANCH COUNTY REMONUMENTATION CORNER LAND CORNER RECORDATION CERTIFICATE

Filing Requirement of Act 74, Mich. P.A. 1970

For corners in

Table with columns: Branch (County), Located In, Corner Code #. Includes entries for Public Land Survey, Property Controlling in Section, and Miscellaneous Property in Sec.

STATE OF MICHIGAN Branch County Recorded

12-28-1994 15:01:27

Linda Lee Morrison-Mathews REGISTER OF DEEDS

Liber 00002 Page 0295

Register of Deeds Stamp & File Number

- 4. Lot No. , Recorded Plat
5. Private Claims


Grid table with columns A-M and rows 2-13. A small dot is marked in cell J12.

I, Edward W. Reed, in a field survey on September 23, 1994, do hereby certify that under requirements of P.A. 74, Michigan P.A. of 1970, the corner points mentioned in lines 1 and 2 above were in conformance with regulations and rules therefore as required in the current manual of survey instructions of the United States Department of the Interior...

NOTE: Not more than 4 corners, all in the same town and range, may be recorded on this certificate.

A. Description of original monument and accessories and/or subsequent restoration: Northwest corner Section 1 and Northeast corner Section 2, Town 5 South, Range 7 West, Union Township, Branch County, Michigan. 1825: GLO notes, corner set 1873: Ricker, long stone, cobbles and brick, 157 links West of Burlington Corner 1993: E. W. Reed, found iron stake at offset distance from Calhoun corner

B. Description of corner evidence found and/or method applied in restoring or reestablishing corner: Found 1/2" iron agreeing with old witness Removed iron and dug down 3' and found pointed stone along side iron Replaced iron with 1/2" x 18" rebar and remonumentation cap Set cast iron box flush with road

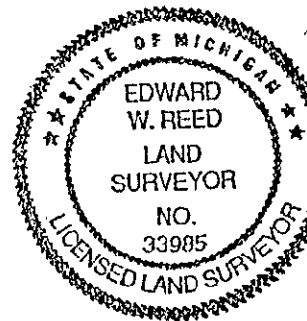

C. Description of monument for corner and accessories established to perpetuate locating the position of the corner: 1/2" rebar as noted above: North 18 East 34.0'-to face of telephone pedestal East 54.6'-intersection of roads North 3.8'-to centerline of East-West roads South 30 East 30.8'-West end of CMP

And is accepted as a careful and faithful perpetuation of the position of the original corner.

Signed by Edward W. Reed Date September 23, 1994 Surveyor's Michigan License No. 33985