

SURVEY & REMONUMENTATION

APR 26 1995

LAND CORNER REGISTRATION CERTIFICATE
Filing Requirement of Act 74, Mich. P.A. 1970

ACCEPTED BY THE BRANCH COUNTY SURVEY PEER GROUP AS THE OFFICIAL CORNER UNDER MICHIGAN PUBLIC ACT 345 OF 1990 AT A MEETING HELD ON

12-16-94

E. Reed, Co. Rep.

For corners in

<u>Branch</u> <small>(County)</small>	Located In:	Corner Code <u>##</u>	
1. Public Land Survey	T <u>5</u> S R <u>7</u> W	<u>K-3</u>	
	T _____ R _____	_____	
	T _____ R _____	_____	
	T _____ R _____	_____	
2. Property Controlling in Section	S _____ T _____ R _____	_____	
	S _____ T _____ R _____	_____	
3. Miscellaneous Property in Sec.	S _____ T _____ R _____	_____	
	S _____ T _____ R _____	_____	
4. Lot No. _____, Recorded Plat _____			
5. Private Claims _____			

STATE OF MICHIGAN
Branch County
Recorded

12-28-1994 15:01:45
Register of Deeds Stamp & File Number
12-28-1994 15:01:45
REGISTER OF DEEDS

	A	B	C	D	E	F	G	H	I	J	K	L	M
2	6	5	4	3	2	1							
3											●		
4	7	8	9	10	11	12							
5													
6	10	17	16	15	14	13							
7													
8	19	20	21	22	23	24							
9													
10	30	29	28	27	26	25							
11													
12	31	32	33	34	35	36							
13													

I, Edward W. Reed, in a field survey on October 31, 19 94, do hereby certify that under requirements of P.A. 74, Michigan P.A. of 1970, the corner points mentioned in lines 1 and 2 above were in conformance with regulations and rules therefore as required in the current manual of survey instructions of the United States Department of the Interior, Bureau of Land Management or by a decree of a Court of Law and/or that the corner points mentioned in lines 3, 4 and 5 above were in conformance with the rules of the Michigan Board of Land Surveyors or by a Decree of a Court of Law; established, re-established, monumented, re-monumented, recovered, found as expressed below:

NOTE: Not more than 4 corners, all in the same town and range, may be recorded on this certificate.

A. Description of original monument and accessories and/or subsequent restoration:


Corner common to Sections 1, 2, 11 and 12, Town 5 South, Range 7 West, Union Township, Branch County, Michigan.
1825: GLO notes, corner set
1873: Ricker, stone with notch in top
1993: E. W. Reed, found old iron stake, set 1/2" iron over top

B. Description of corner evidence found and/or method applied in restoring or reestablishing corner:

Found 1/2" iron as described in survey by Edward W. Reed and agreeing with old witness
Set cast iron monument box flush with road witness surface

C. Description of monument for corner and accessories established to perpetuate locating the position:

1/2" rebar as noted above:
South 60 East 72.6' -to face of telephone pedestal
North 42 West 46.0' -to face of power pole
North 20 West 78.9' -to face of telephone pedestal
North 72 East 75.0' -to face of telephone pedestal

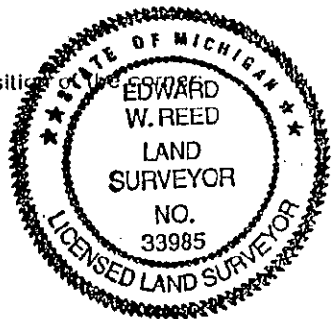

And is accepted as a careful and faithful perpetuation of the position of the original corner.

Signed by Edward W. Reed Date October 31, 1994
Surveyor's Michigan License No. 33985