

SURVEY & REMONUMENTATION

APR 26 1995

ACCEPTED BY THE BRANCH COUNTY SURVEY PRER GROUP AS THE OFFICIAL CORNER UNDER MICHIGAN PUBLIC ACT 345 OF 1990 AT A MEETING HELD ON

12-16-94

E. Reed, Co. Rep.

BRANCH ~~COMMISSION~~ RECONSTITUTION CORNER
LAND CORNER RECORDATION CERTIFICATE
Filing Requirement of Act 74, Mich. P.A. 1970

STATE OF MICHIGAN
Branch County
Recorded

For corners in

Branch _____ <small>(County)</small>	Located In:	Corner Code ##	
1. Public Land Survey	T <u>5</u> S R <u>7</u> W	K-5	
	T _____ R _____	_____	
	T _____ R _____	_____	
	T _____ R _____	_____	
2. Property Controlling in Section	S _____ T _____ R _____	_____	
	S _____ T _____ R _____	_____	
3. Miscellaneous Property in Sec.	S _____ T _____ R _____	_____	
	S _____ T _____ R _____	_____	
4. Lot No. _____, Recorded Plat _____			
5. Private Claims _____			

12-28-1994 15:01:56

Linda Lee Morrison-Mathews
REGISTER OF DEEDS

Liber **00002** Page **0298**

Register of Deeds Stamp & File Number


I, Edward W. Reed, in a field survey on October 31, 19 94, do hereby certify that under requirements of P.A. 74, Michigan P.A. of 1970, the corner points mentioned in lines 1 and 2 above were in conformance with regulations and rules therefore as required in the current manual of survey instructions of the United States Department of the Interior, Bureau of Land Management or by a decree of a Court of Law and/or that the corner points mentioned in lines 3, 4 and 5 above were in conformance with the rules of the Michigan Board of Land Surveyors or by a Decree of a Court of Law; established, re-established, monumented, re-monumented, recovered, found as expressed below:

NOTE: Not more than 4 corners, all in the same town and range, may be recorded on this certificate.

	A	B	C	D	E	F	G	H	I	J	K	L	M
2	6		5		4		3		2		1		
3													
4	7		8		9		10		11		12		
5													
6	18		17		16		15		14		13		
7													
8	19		20		21		22		23		24		
9													
10	30		29		28		27		26		25		
11													
12	31		32		33		34		35		36		
13													

A. Description of original monument and accessories and/or subsequent restoration:
 Corner common to Sections 11, 12, 13, and 14, Union Township, Branch County, Michigan.
 (Town 5 South, Range 7 West)
 1825: GLO notes, corner
 1979: Cutcher, railroad spike over gray stone
 1990: E. W. Reed, found pointed white stone, placed iron clay spade over top

B. Description of corner evidence found and/or method applied in restoring or reestablishing corner:
 Found 1" solid clay spade which could not be removed
 Set 1/2" x 18" rebar and remonumentation cap along side and in the correct position

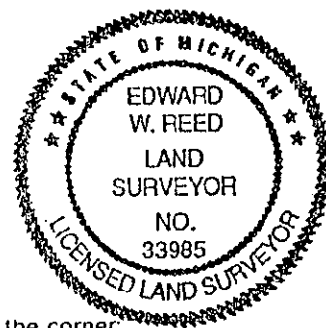

C. Description of monument for corner and accessories established to perpetuate locating the position of the corner:
 1/2" rebar as noted above:
 North 88 East 97.7'-to face of power pole
 South 43 East 109.3'-to Northwest corner of house
 North 73 East 125.2'-to Southwest corner of barn
 North 41 West 33.1'-to face of power pole

And is accepted as a careful and faithful perpetuation of the position of the original corner.

Signed by Edward W. Reed Date October 31, 1994
 Edward W. Reed
 Surveyor's Michigan License No. 33985