

**SURVEY &
REMONUMENTATION**

APR 26 1995

ACCEPTED BY THE BRANCH COUNTY SURVEY PEER GROUP AS THE OFFICIAL CORNER UNDER MICHIGAN PUBLIC ACT 345 OF 1990 AT A MEETING HELD ON 12-16-94

E. Reed C. Reed

**BRANCH COUNTY REMONUMENTATION CORNER
LAND CORNER RECORDATION CERTIFICATE**
Filing Requirement of Act 74, Mich. P.A. 1970

For corners in

<u>Branch</u> (County)	<u>Located In:</u>	<u>Corner Code #</u>
1. Public Land Survey	T <u>5</u> S R <u>7</u> W	<u>K-7</u>
	T _____ R _____	_____
	T _____ R _____	_____
	T _____ R _____	_____
2. Property Controlling in Section	S _____ T _____ R _____	_____
	S _____ T _____ R _____	_____
3. Miscellaneous Property in Sec.	S _____ T _____ R _____	_____
	S _____ T _____ R _____	_____

STATE OF MICHIGAN
Branch County
Recorded

12-28-1994 15:02:14

Linda Lee Morrison-Mathews
REGISTERED CLERK Page 0500
Register of Deeds Stamp & File Number

4. Lot No. _____, Recorded Plat _____
5. Private Claims _____

A	B	C	D	E	F	G	H	I	J	K	L	M
2	6	5	4	3	2	1						
3												
4	7	8	9	10	11	12						
5												
6	18	17	16	15	14	13						
7												
8	19	20	21	22	23	24						
9												
10	30	29	28	27	26	25						
11												
12	31	32	33	34	35	36						
13												


I, Edward W. Reed, in a field survey on September 23, 19 94, do hereby certify that under requirements of P.A. 74, Michigan P.A. of 1970, the corner points mentioned in lines 1 and 2 above were in conformance with regulations and rules therefore as required in the current manual of survey instructions of the United States Department of the Interior, Bureau of Land Management or by a decree of a Court of Law and/or that the corner points mentioned in lines 3, 4 and 5 above were in conformance with the rules of the Michigan Board of Land Surveyors or by a Decree of a Court of Law; established, re-established, monumented, re-monumented, recovered, found as expressed below:

NOTE: Not more than 4 corners, all in the same town and range, may be recorded on this certificate.

A. Description of original monument and accessories and/or subsequent restoration:
Corner common to Sections 13, 14, 23 and 24, Town 5 South, Range 7 West, Union Township, Branch County, Michigan.
1825: GLO, set post
1978: Cutcher, dug for corner found 40d spike with red paint 22" below road, set 1/2" iron, recorded #226
1990: E. W. Reed, found 1/2 rod set by Cutcher

B. Description of corner evidence found and/or method applied in restoring or reestablishing corner:
Found 1/2" iron as described by LCRC #226, by Frederick J. Cutcher, Surveyor
(Note: Road intersection has been raised by about 4' higher than surrounding land-no traces of anything else around iron)
Set remonumentation cap on iron and cast iron box flush with road surface

C. Description of monument for corner and accessories established to perpetuate locating the position of the corner:
1/2" iron as noted above:
South 45 East 40.95-railroad tie anchor post
North 30 West 31.90-West end of 24" CMP
North 30 East 34.10-East end of 24" CMP
South 79 West 117.37-near face of power pole
North 50 West 49.75-near face of telephone pedestal

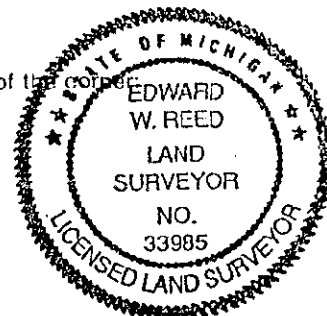

And is accepted as a careful and faithful perpetuation of the position of the original corner.

Signed by Edward W. Reed Date September 23, 1994
Surveyor's Michigan License No. 33985