

SURVEY & REMONUMENTATION

APR 26 1995

ACCEPTED BY THE BRANCH COUNTY SURVEY PEER GROUP AS THE OFFICIAL CORNER UNDER MICHIGAN PUBLIC ACT 345 OF 1990 AT A MEETING HELD ON 12-16-90

BRANCH COUNTY REMONUMENTATION CORNER
COMMISSION
LAND CORNER RECORDATION CERTIFICATE
Filing Requirement of Act 74, Mich. P.A. 1970

E. P. Reed Co. Rep.
For corners in

<u>Branch</u> <small>(County)</small>	Located In:	Corner Code ://	
UNION TOWNSHIP			
1. Public Land Survey	T <u>5</u> S R <u>7</u> W	<u>L-1</u>	
	T _____ R _____	_____	
	T _____ R _____	_____	
	T _____ R _____	_____	
2. Property Controlling in Section	S _____ T _____ R _____	_____	
	S _____ T _____ R _____	_____	
3. Miscellaneous Property in Sec.	S _____ T _____ R _____	_____	
	S _____ T _____ R _____	_____	
4. Lot No. _____, Recorded Plat _____			
5. Private Claims _____			

STATE OF MICHIGAN
Branch County
Recorded

12-28-1994 15:07:33
Liber 00002 Page 0302
Linda Lee Morrison-Mathews
Register of Deeds Stamp & File Number

I, Edward W. Reed, in a field survey on December 14, 19 94, do hereby certify that under requirements of P.A. 74, Michigan P.A. of 1970, the corner points mentioned in lines 1 and 2 above were in conformance with regulations and rules therefore as required in the current manual of survey instructions of the United States Department of the Interior, Bureau of Land Management or by a decree of a Court of Law and/or that the corner points mentioned in lines 3, 4 and 5 above were in conformance with the rules of the Michigan Board of Land Surveyors or by a Decree of a Court of Law; established, re-established, monumented, re-monumented, recovered, found as expressed below:


	A	B	C	D	E	F	G	H	I	J	K	L	M
2	6		5		4		3		2		1		
3													
4	7		8		9		10		11		12		
5													
6	13		17		16		15		14		13		
7													
8	19		20		21		22		23		24		
9													
10	30		29		28		27		26		25		
11													
12	31		32		33		34		35		36		
13													

NOTE: Not more than 4 corners, all in the same town and range, may be recorded on this certificate.

A. Description of original monument and accessories and/or subsequent restoration:
North Quarter corner Section 1, Town 5 South, Range 7 West, Union Township, Branch County, MI.
1825: Brookfield, corner set
1873: Ricker, stone with cobbles

B. Description of corner evidence found and/or method applied in restoring or reestablishing corner:
Split section line in half, prorated 1/4 fences. Dug 4' x 4' x 4' hole. Nothing found.
Reset corner on North line of Section and midway between corners
Set 1/2" x 24" rebar, remonumentation cap and cast iron box flush with road surface

C. Description of monument for corner and accessories established to perpetuate locating the position of the corner.
1/2" rebar as noted above:
N 72 E 57.22' nail and washer 2' up side of 36" oak
S 43 E 41.79' nail and washer 2' up N side of cherry
N 45 W 41.34' nail and washer 2' up S side 6" maple
Due E 53.1 line of fenceline running N

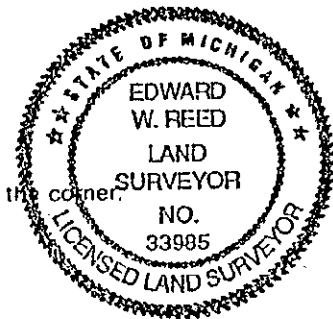

And is accepted as a careful and faithful reestablishment of the position of the original corner.

Signed by Edward W. Reed Date December 14, 1994
Surveyor's Michigan License No. 33985
EDWARD W. REED