

SECTION

BRANCH COUNTY REMONUMENTATION CORNER STATE OF MICHIGAN
LAND CORNER RECORDATION CERTIFICATE Branch County
Filing Requirement of Act 74, Mich. P.A. 1970 Recorded

For corners in

| | | |
|---------------------------------------|-------------------------|---------------|
| <u>BRANCH</u> (County) | Located In: | Corner Code # |
| SHERWOOD TOWNSHIP | T <u>5S</u> R <u>8W</u> | <u>C-10</u> |
| 1. Public Land Survey | T _____ R _____ | _____ |
| | T _____ R _____ | _____ |
| | T _____ R _____ | _____ |
| 2. Property Controlling in Section | S _____ T _____ R _____ | _____ |
| | S _____ T _____ R _____ | _____ |
| 3. Miscellaneous Property in Sec. | S _____ T _____ R _____ | _____ |
| | S _____ T _____ R _____ | _____ |
| 4. Lot No. _____, Recorded Plat _____ | | |
| 5. Private Claims _____ | | |

12-30-1999 11:02:14

Linda Lee Morrison-Mathews
REGISTER OF DEEDS

Liber 00004 Page 0059

Register of Deeds Stamp & File Number

I, ROBERT R. CARR, in a field survey on NOVEMBER 3, 1999 do hereby state that under requirements of P.A. 74, Michigan P.A. of 1970, the corner points mentioned in lines 1 and 2 above were in conformance with regulations and rules therefore as required in the current manual of survey instructions of the United States Department of the Interior, Bureau of Land Management or by a decree of a Court of Law and /or that the corner points mentioned in lines 3, 4 and 5 above were in conformance with the rules of the Michigan Board of Land Surveyors or by a Decree of a Court of Law; established, re-established, monumented, recovered, found as expressed below:

NOTE: Not more than 2 corners, all in the same town and range, may be recorded on this certificate.

A. Description of original monument and accessories and/or subsequent restoration:

ORIGINAL CORNER SET BY JOHN MULLETT, D.S., 1829
CHAS. HAMILTON, CO. SURVEYOR (NO DATE) FOUND TRACES OF OLD CORNER TREES IN HIGHWAY AND PLANTED STONE WITH DEPOSIT OF BRICK.
"BLOSSOM LAKE PLAT" REFERENCED TO CORNER.
NOTES FOR "BLOSSOM LAKE PLAT", FOUND PIECES OF BRICK, WOOD STAKE, SET NAIL IN GRAVEL ROAD.

| | | | | | | | | | | | | | |
|----|----|---|----|---|----|---|----|---|----|---|----|---|---|
| | A | B | C | D | E | F | G | H | I | J | K | L | M |
| 1 | | | | | | | | | | | | | |
| 2 | 6 | | 5 | | 4 | | 3 | | 2 | | 1 | | |
| 3 | | | | | | | | | | | | | |
| 4 | 7 | | 8 | | 9 | | 10 | | 11 | | 12 | | |
| 5 | | | | | | | | | | | | | |
| 6 | 18 | | 17 | | 16 | | 15 | | 14 | | 13 | | |
| 7 | | | | | | | | | | | | | |
| 8 | 19 | | 20 | | 21 | | 22 | | 23 | | 24 | | |
| 9 | | | | | | | | | | | | | |
| 10 | 30 | | 29 | | 28 | | 27 | | 26 | | 25 | | |
| 11 | | | | | | | | | | | | | |
| 12 | 31 | | 32 | | 33 | | 34 | | 35 | | 36 | | |
| 13 | | | | | | | | | | | | | |

B. Description of corner evidence found and/or method applied in restoring or reestablishing corner:


ESTABLISHED CORNER LOCATION FROM MONUMENTATION OF PLAT OF "BLOSSOM LAKE PLAT".
DUG AT THIS LOCATION AND FOUND THREE LARGE STONES 1.5' ± DEEP.
ACCEPTED THIS LOCATION AS BEST EVIDENCE OF ORIGINAL CORNER AND SET BRANCH COUNTY REMONUMENTATION IRON AND CAP.

ACCEPTED BY THE BRANCH COUNTY SURVEY PEER GROUP AS THE OFFICIAL CORNER UNDER MICHIGAN PUBLIC ACT 345 OF 1990 AT A MEETING HELD ON 12-07-1999

E.R. Reed, P.S.
E.R. REED

C. Description of monument for corner and accessories established to perpetuate locating the position of the corner:

BRANCH COUNTY REMONUMENTATION IRON AND CAP IN MONUMENT BOX.
7" OAK, N46°E 43.35 FEET, SET NAIL AND SPOTTER
8" OAK, N31°E 56.76 FEET, SET NAIL AND SPOTTER
UTILITY POLE, N72°W 34.15 FEET, SET NAIL AND SPOTTER
9" PIN OAK, S71°W 68.72 FEET, SET NAIL AND SPOTTER
8" PIN OAK, S40°E 45.08 FEET, SET NAIL AND SPOTTER
PLAT MONUMENT WEST 33 FEET.

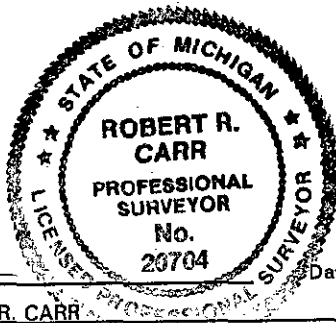

Signed by [Signature] Date DEC. 7, 1999
Surveyor's Michigan License No. 20704 ROBERT R. CARR