

FEB 1 2000

SECTION

BRANCH COUNTY REMONUMENTATION CORNER  
LAND CORNER RECORDATION CERTIFICATE  
Filing Requirement of Act 74, Mich. P.A. 1970

STATE OF MICHIGAN  
Branch County  
Recorded

For corners in

<u>BRANCH</u> (County)	Located In:	Corner Code #
SHERWOOD TOWNSHIP	T <u>5S</u> R <u>8W</u>	<u>E-6</u>
1. Public Land Survey	T _____ R _____	_____
	T _____ R _____	_____
	T _____ R _____	_____
2. Property Controlling in Section	S _____ T _____ R _____	_____
	S _____ T _____ R _____	_____
3. Miscellaneous Property in Sec.	S _____ T _____ R _____	_____
	S _____ T _____ R _____	_____

12-30-1999 11:02:07

Linda Lee Morrison-Mathews  
REGISTER OF DEEDS

Liber **00004** Page **0058**

Register of Deeds Stamp & File Number

4. Lot No. \_\_\_\_\_, Recorded Plat \_\_\_\_\_  
5. Private Claims \_\_\_\_\_

I, ROBERT R. CARR, in a field survey on NOVEMBER 1, 1999 do hereby state that under requirements of P.A. 74, Michigan P.A. of 1970, the corner points mentioned in lines 1 and 2 above were in conformance with regulations and rules therefore as required in the current manual of survey instructions of the United States Department of the Interior, Bureau of Land Management or by a decree of a Court of Law and /or that the corner points mentioned in lines 3, 4 and 5 above were in conformance with the rules of the Michigan Board of Land Surveyors or by a Decree of a Court of Law; established, re-established, monumented, recovered, found as expressed below:

NOTE: Not more than 2 corners, all in the same town and range, may be recorded on this certificate.

A. Description of original monument and accessories and/or subsequent restoration:

ORIGINAL CORNER SET BY JOHN MULLETT, D.S., 1826  
CHAS. HAMILTON, CO. SURVEYOR, 1882, FOUND STAKE AND ONE WITNESS.  
SURVEY IN SECTION 16 BY J.H. BENNETT, 1890 SHOWS CORNER USED BUT GAVE NO DESCRIPTION OR WITNESSES.  
E.L. MINER, CO. SURVEYOR, 1926, FOUND 1" GAS PIPE, STONE AND BRICK 12 FEET EAST OF CENTERLINE OF TRACK, ANCHOR POST W. 34.3, LOCUST TREE 4" N ABOUT 5°E 36 FT, NW CORNER OF HOUSE SE 126.5 FT.  
E.L. MINER, CO. SURVEYOR, 1929, FOUND 1/4 CORNER BETWEEN SECTIONS 16 & 17 . WITNESS CARD, NO DATE, CALLS FOR FOUND 1/2" IRON IN ROAD DITCH E. SIDE OF ROAD AND IN LINE WITH FENCE RUNNING WEST, NW CORNER HOUSE SE 126.5, SW CORNER CONC. BLOCK HOUSE, N85°E 76.32, WOOD ANCHOR POST WITH FENCE E&NW N. 44.93, 36" MAPLE S2°E, 132.55.

	A	B	C	D	E	F	G	H	I	J	K	L	M
1													
2	6	5		4	3			2		1			
3													
4	7	8		9	10			11		12			
5													
6	16	17	16	15	14			13					
7													
8	19	20	21	22	23			24					
9													
10	30	29	28	27	26			25					
11													
12	31	32	33	34	35			36					
13													

ACCEPTED BY THE BRANCH COUNTY SURVEY PEER GROUP AS THE OFFICIAL CORNER UNDER MICHIGAN PUBLIC ACT 345 OF 1990 AT A MEETING HELD ON 12-07-1999

E.R. Reed P.S.  
E.R. REED


B. Description of corner evidence found and/or method applied in restoring or reestablishing corner:

FOUND 5/8" REBAR, RECORD WITNESS TO CONC. BLOCK HOUSE, N85°E, 76.32, MEASURES 77.96 FEET  
RECORD WITNESS TO NW CORNER HOUSE SE126.5, MEASURES 127.07 FEET.  
DUG AT INTERSECTION OF OLD WITNESSES AND FOUND CHUNKS OF BRICK WITH GAS PIPE LYING DOWN ABOUT 2 FEET DEEP.  
SET REMONUMENTATION IRON AND CAP AT INTERSECTION OF RECORD DISTANCES FROM HOUSES 76.32 FEET AND 126.5 FEET.

THIS LOCATION ACCEPTED AS BEST AVAILABLE EVIDENCE OF ORIGINAL CORNER.

C. Description of monument for corner and accessories established to perpetuate locating the position of the corner:

BRANCH COUNTY REMONUMENTATION STAKE AND CAP IN MONUMENT BOX WITH ROCK AND CONCRETE RUBBLE AROUND.  
20" WALNUT, S20°E 32.17 FEET, SET NAIL AND SPOTTER  
SW CORNER OF CONCRETE PILLAR, N17°E 30.53 FEET  
10" MAPLE, S70°W 59.81 FEET, SET NAIL AND SPOTTER  
SW CORNER OF CONCRETE BLOCK HOUSE, N85°E 76.32 FEET  
NW CORNER OF FRAME HOUSE (RUINS), S50°E 126.5 FEET  
13.80 FEET EASTERLY OF EDGE OF PAVEMENT.

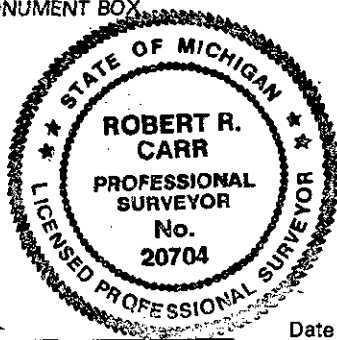

Signed by [Signature]

Date DEC. 7, 1999

Surveyor's Michigan License No. 20704 ROBERT R. CARR