

SURVEY & REMONUMENTATION

MAR 21 1997

COMMISSION

BRANCH COUNTY REMONUMENTATION
LAND CORNER RECORDATION CERTIFICATE **iber 00003** Page **0105**
Filing Requirement of Act 74, Mich. P.A. 1970

For corners in

Branch <small>(County)</small>	Located In:	Corner Code \neq
Sherwood Twp		
1. Public Land Survey Sec 33	T <u>5</u> S R <u>8</u> W	<u>E-12</u>
	T _____ R _____	_____
	T _____ R _____	_____
	T _____ R _____	_____
2. Property Controlling in Section	S _____ T _____ R _____	_____
	S _____ T _____ R _____	_____
3. Miscellaneous Property in Sec.	S _____ T _____ R _____	_____
	S _____ T _____ R _____	_____

STATE OF MICHIGAN
Branch County
Recorded

12-30-1996 14:11:20

Linda Lee Morrison-Mathews
REGISTER OF DEEDS

Register of Deeds Stamp & File Number

4. Lot No. _____, Recorded Plat _____
5. Private Claims _____

	A	B	C	D	E	F	G	H	I	J	K	L	M
2	6	5	4	3	2	1							
3													
4	7	8	9	10	11	12							
5													
6	18	17	16	15	14	13							
7													
8	19	20	21	22	23	24							
9													
10	30	29	28	27	26	25							
11													
12	31	32	33	34	35	36							
13													

I, Robert R. Carr, in a field survey on October 30, 19 96, do hereby certify that under requirements of P.A. 74, Michigan P.A. of 1970, the corner points mentioned in lines 1 and 2 above were in conformance with regulations and rules therefore as required in the current manual of survey instructions of the United States Department of the Interior, Bureau of Land Management or by a decree of a Court of Law and/or that the corner points mentioned in lines 3, 4 and 5 above were in conformance with the rules of the Michigan Board of Land Surveyors or by a Decree of a Court of Law; established, re-established, monumented, re-monumented, recovered, found as expressed below:

NOTE: Not more than 4 corners, all in the same town and range, may be recorded on this certificate.

West 1/4 corner Section 33 Sherwood Twp T5S R8W Branch

A. Description of original monument and accessories and/or subsequent restoration: Co MI

1. G.L.O.: original corner set by J. Mullett D.S. 1825 - 1826
White Oak 5" S29-1/2°E 194 lks Aspen 6" N38°W 98 lks
2. John J. Cox 1913 found stone 24" long set on end
Cherry 18" NE 136 lks; Hickory 12" SW 89 lks

B. Description of corner evidence found and/or method applied in restoring or reestablishing corner:

Found Hickory witness tree from J.J. Cox 1913; measured distance NE to centerline of gravel road; dug and found 14"x12"x3" stone on end but leaning to South 5 other stone and a horse shoe around it; Top of stone broken off.


Lowered stones and set 1/2" iron with Branch County Remonumentation Cap in monument box 6" below gravel surface.

ACCEPTED BY THE BRANCH COUNTY
SURVEY PFR GROUP AS THE OFFICIAL
CORNER UNDER MICHIGAN PUBLIC ACT 345
OF 1990 AT A MEETING HELD ON
NOV. 13, 1996

E. Reed, Co. Rep.
E.R. REED

C. Description of monument for corner and accessories established to perpetuate locating the position of the corner:

- 1/2" rebar with Branch County Remonumentation Cap in monument box.
 - Nail & spotter in scar on Westerly side 32" Hickory S24°W 58.74 feet.
 - Nail & spotter in Westerly side 40" Oak S29°E 68.28 feet.
 - Nail & spotter in Southerly side 30" Walnut S88°E 69.68 feet.
 - Nail & spotter in Northerly side 4" Oak N71°W 34.02 feet.
 - Nail & spotter in Westerly side 12" Walnut S06°E 166.29 feet.
 - 3± West centerline North/South Road
 - Tree row to East.
- And is accepted as a careful and faithful perpetuation of the position of the original corner.

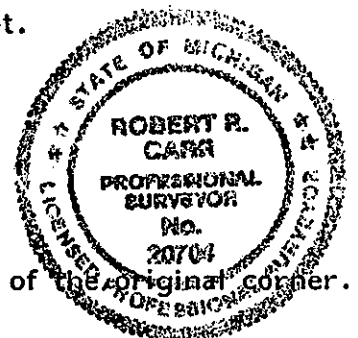

Signed by Robert R. Carr Date November 12, 1996
Surveyor's Michigan License No. 20704