

ACCEPTED BY THE BRANCH COUNTY SURVEY PEER GROUP AS THE OFFICIAL CORNER UNDER MICHIGAN PUBLIC ACT 345 OF 1990 AT A MEETING HELD ON

Nov. 13, 1996

E.R. Reed Co. Rep.
E.R. REED

Filing Requirement of Act 74, Mich. P.A. 1970 STATE OF MICHIGAN

For corners in

Branch (County)	Located In:	Corner Code ##
Sherwood Twp		
1. Public Land Survey Sec 33	T 5 S R 8 W	G-11
	T _____ R _____	_____
	T _____ R _____	_____
	T _____ R _____	_____
2. Property Controlling in Section	S _____ T _____ R _____	_____
	S _____ T _____ R _____	_____
3. Miscellaneous Property in Sec.	S _____ T _____ R _____	_____
	S _____ T _____ R _____	_____

Branch County Recorded

12-30-1996 14:11:40

Linda Lee Morrison-Mathews
REGISTER OF DEEDS

SURVEY & REMONUMENTATION

Register of Deeds Stamp & File Number

4. Lot No. _____, Recorded Plat _____
5. Private Claims _____

MAR 21 1997

COMMISSION

I, Robert R. Carr, in a field survey on October 31, 19 96, do hereby certify that under requirements of P.A. 74, Michigan P.A. of 1970, the corner points mentioned in lines 1 and 2 above were in conformance with regulations and rules therefore as required in the current manual of survey instructions of the United States Department of the Interior, Bureau of Land Management or by a decree of a Court of Law and/or that the corner points mentioned in lines 3, 4 and 5 above were in conformance with the rules of the Michigan Board of Land Surveyors or by a Decree of a Court of Law; established, re-established, monumented, re-monumented, recovered, found as expressed below:

NOTE: Not more than 4 corners, all in the same town and range, may be recorded on this certificate.

	A	B	C	D	E	F	G	H	I	J	K	L	M
2	6	5	4	3	2	1							
3													
4	7	8	9	10	11	12							
5													
6	18	17	16	15	14	13							
7													
8	19	20	21	22	23	24							
9													
10	30	29	28	27	26	25							
11													
12	31	32	33	34	35	36							

NE corner Section 33 Sherwood Twp T5S R8W Branch Co MI 13

A. Description of original monument and accessories and/or subsequent restoration:


- G.L.O.: J. Mullett D.S. 1825-1826 Black Oak 8" N30-1/2°W 24 lks.
Black Oak 10" S30-1/2°E 450 lks.
- Bennett 1879 found stone Sugar 12" S4-1/2°W 41 lks.; Sugar 10" N58-3/4°W 55-1/8 lks.
- Hamilton County Surveyor 1901 found stone
- Hamilton 1882 found stone
- Miner County Surveyor 1895 found stone
- LCRC No. 088 by D. Boone, RLS 1974

B. Description of corner evidence found and/or method applied in restoring or reestablishing corner:

Found one witness tree by Bennett 1879 still standing and stump of other, Sugar 10" is now 40' and 12" sugar is a large stump
Intersected distances from these and found a 13"x7"x7" stone set on end 1 ft± below surface of blacktop road, measured 27.60 (record 27.04) to center of stump and 36.2 (record 36.3) to center of 40" maple. Also checked distances to East from Miner survey 1895 to West 1/16 line and N & S 1/4 line Section 34 and found to fit occupation. Also found 1/2" iron with cap No. 18803 by Boone (LCRC No. 088) 1 ft East and 3.5 feet South of stone.
Disregarded Boone iron and accepted stone as best evidence of corner.

C. Description of monument for corner and accessories established to perpetuate locating the position of the corner:

Placed 1/2" rebar with Branch County Remonumentation Cap in monument box over stone.
SE corner house #245 foundation N52°W 110.72 feet.
SE corner house #249 foundation N25°W 73.00 feet.
Nail & spotter in Southerly side U-Pole S80°E 298.51 feet.
Nail & spotter in Westerly side U-Pole S26°E 25.12 feet.
Nail & spotter in Northerly side 40" Maple S82°W 137.26 feet.
Nail & spotter in Easterly side 40" Maple N44°W 36.38 feet.
Tree row North; no occupation South.
And is accepted as a careful and faithful perpetuation of the position of the original corner.

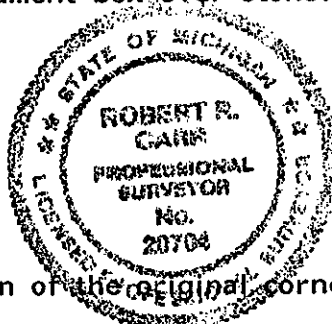

Signed by Robert R. Carr
Surveyor's Michigan License No. 20704

Date November 12, 1996