

SURVEY & REMONUMENTATION

MAR 21 1997

COMMISSION

**BRANCH COUNTY REMONUMENTATION
LAND CORNER RECORDATION CERTIFICATE**
Filing Requirement of Act 74, Mich. P.A. 1970

STATE OF MICHIGAN
Branch County
Recorded

For corners in

Branch (County)	Located In:	Corner Code #
1. Public Land Survey	T <u>5</u> S R <u>8</u> W	<u>G-12</u>
	T _____ R _____	_____
	T _____ R _____	_____
	T _____ R _____	_____
2. Property Controlling in Section	S _____ T _____ R _____	_____
	S _____ T _____ R _____	_____
3. Miscellaneous Property in Sec.	S _____ T _____ R _____	_____
	S _____ T _____ R _____	_____

12-30-1996 14:11:47

Linda Lee Morrison-Mathews
REGISTER OF DEEDS

Liber **00003** Page **0109**
Register of Deeds Stamp & File Number

4. Lot No. _____, Recorded Plat _____
5. Private Claims _____

I, Robert R. Carr, in a field survey on November 1, 19 96, do hereby certify that under requirements of P.A. 74, Michigan P.A. of 1970, the corner points mentioned in lines 1 and 2 above were in conformance with regulations and rules therefore as required in the current manual of survey instructions of the United States Department of the Interior, Bureau of Land Management or by a decree of a Court of Law and/or that the corner points mentioned in lines 3, 4 and 5 above were in conformance with the rules of the Michigan Board of Land Surveyors or by a Decree of a Court of Law; established, re-established, monumented, re-monumented, recovered, found as expressed below:

NOTE: Not more than 4 corners, all in the same town and range, may be recorded on this certificate.

	A	B	C	D	E	F	G	H	I	J	K	L	M
2	6		5		4		3		2		1		
3													
4	7		8		9		10		11		12		
5													
6	18		17		16		15		14		13		
7													
8	19		20		21		22		23		24		
9													
10	30		29		28		27		26		25		
11													
12	31		32		33		34		35		36		
13													

A. Description of original monument and accessories and/or subsequent restoration:

West quarter corner of Section 33 Sherwood Township, T5S, R8W, Branch Co. MI.
1825 - 1826: J. Mullett Dep. Surveyor G.L.O.
1895: I.D. Miner found rotten stake & fences, set boulder 14" long point up.
1974: Boone, R.L.S. found stone LCRC No. 088.

B. Description of corner evidence found and/or method applied in restoring or reestablishing corner:


Found 14"x5"x8" stone set on end at Southwesterly side of ring of stones from old fnc corner
Fallen fences North, South, East & West
Accepted stone as true perpetuation of corner.

ACCEPTED BY THE BRANCH COUNTY
SURVEY PEER GROUP AS THE OFFICIAL
CORNER UNDER MICHIGAN PUBLIC ACT 345
OF 1990 AT A MEETING HELD ON
Nov. 13, 1996

E.R. Reed, C. Rep.
E.R. REED

C. Description of monument for corner and accessories established to perpetuate locating the position of the corner:

Set 1/2" rebar with Branch County Remonumentation Cap,
18" Water Locust S43°E 35.74 feet
20" Water Locust S89°E 61.73 feet
16" Ash N01°E 26.33 feet
12" Maple N79°W 37.77 feet
6" Maple S66°E 28.79 feet

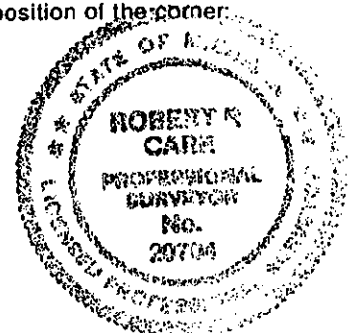

And is accepted as a careful and faithful perpetuation of the position of the original corner

Signed by Robert R. Carr Date November 13, 1996
Surveyor's Michigan License No. 20704