

# SURVEY & REMONUMENTATION

MAR 21 1997

COMMISSION

## BRANCH COUNTY REMONUMENTATION CORNER LAND CORNER RECORDATION CERTIFICATE Filing Requirement of Act 74, Mich. P.A. 1970

For corners in

BRANCH _____	Located In:	Corner Code #
SHERWOOD TWP. (Copy)		
1. Public Land Survey	T <u>5S</u> R <u>8W</u>	<u>H-9</u>
	T _____ R _____	_____
	T _____ R _____	_____
	T _____ R _____	_____
2. Property Controlling in Section	S _____ T _____ R _____	_____
	S _____ T _____ R _____	_____
3. Miscellaneous Property in Sec.	S _____ T _____ R _____	_____
	S _____ T _____ R _____	_____
4. Lot No. _____, Recorded Plat _____		
5. Private Claims _____		

STATE OF MICHIGAN  
Branch County  
Recorded

12-30-1996 14:11:54

Linda Lee Morrison-Mathews  
REGISTER OF DEEDS

Liber 00003 Page 0110  
Register of Deeds Stamp & File Number  
Liber 00003 Page 0110

	A	B	C	D	E	F	G	H	I	J	K	L	M
2	6	5	4	3	2	1							
3													
4	7	8	9	10	11	12							
5													
6	18	17	16	15	14	13							
7													
8	19	20	21	22	23	24							
9													
10	30	29	28	27	26	25							
11													
12	31	32	33	34	35	36							
13													

I, EDWARD W. REED, in a field survey on NOVEMBER 4, 19 96, do hereby certify that under requirements of P.A. 74, Michigan P.A. of 1970, the corner points mentioned in lines 1 and 2 above were in conformance with regulations and rules therefore as required in the current manual of survey instructions of the United States Department of the Interior, Bureau of Land Management or by a decree of a Court of Law and/or that the corner points mentioned in lines 3, 4 and 5 above were in conformance with the rules of the Michigan Board of Land Surveyors or by a Decree of a Court of Law; established, re-established, monumented, re-monumented, recovered, found as expressed below:

**NOTE:** Not more than 4 corners, all in the same town and range, may be recorded on this certificate.

**A. Description of original monument and accessories and/or subsequent restoration:**

- 1826: J. MULLETT, DEP. SURVEYOR, CORNER SET
- 1879: J. BENNETT, DEP. COUNTY SURVEYOR, "STONE SET"

ACCEPTED BY THE BRANCH COUNTY SURVEY PEER GROUP AS THE OFFICIAL CORNER UNDER MICHIGAN PUBLIC ACT 345 OF 1990 AT A MEETING HELD ON Nov. 13, 1996


*E.R. Reed, Co. Rep.*  
**E.R. REED**

**B. Description of corner evidence found and/or method applied in restoring or reestablishing corner:**

- FOUND 1/2" x 18" IRON, NO CAP
- APPROXIMATELY ON SECTION LINE & APPROXIMATELY MIDWAY BETWEEN SECTION CORNERS EAST AND WEST, FOUND PIECES OF BROKEN BRICK & CROCKERY, NO STONE LOCATED BELOW OR AROUND IRON
- ACCEPTED IRON
- SET 1/2" x 18" IRON, REMONUMENTATION CAP
- SET CAST IRON BOX 1 1/2" BELOW GRAVEL ROAD SURFACE

**C. Description of monument for corner and accessories established to perpetuate locating the position of the corner:**

- 45E 49.75' TO FACE OF TELEPHONE PEDESTAL
- 45E 97.9' TO NW CORNER OF HOUSE
- 45W 41.45' TO RR TIED ANCHOR POST
- 75W 160.0' TO S END OF 60" CMP
- 85W 21.0' TO N END CENTER 60" CMP
- 1/2" x 18" IRON WITH REMONUMENTATION CAP IN CAST IRON BOX

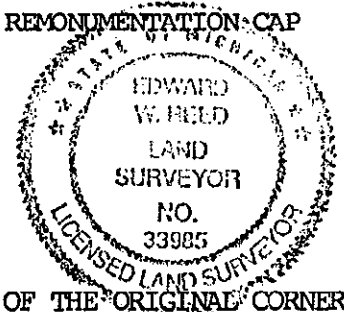

AND IS ACCEPTED AS A CAREFUL AND FAITHFUL PERPETUATION OF THE POSITION OF THE ORIGINAL CORNER.

Signed by Edward W. Reed Date NOVEMBER 4, 1996  
Surveyor's Michigan License No. 33985