

SURVEY & REMONUMENTATION

MAR 13 1998

SECTION _____

**BRANCH COUNTY REMONUMENTATION CORNER
LAND CORNER RECORDATION CERTIFICATE**
Filing Requirement of Act 74, Mich. P.A. 1970

STATE OF MICHIGAN
Branch County
Recorded

For corners in

BRANCH _____ (County)	Located In:	Corner Code #
SHERWOOD TWP.		
1. Public Land Survey	T <u>5</u> S R <u>8</u> W	<u>1-9</u>
	T _____ R _____	_____
	T _____ R _____	_____
	T _____ R _____	_____
2. Property Controlling in Section	S _____ T _____ R _____	_____
	S _____ T _____ R _____	_____
3. Miscellaneous Property in Sec.	S _____ T _____ R _____	_____
	S _____ T _____ R _____	_____

10-22-1997 09:57:49

Linda Lee Morrison-Mathews
REGISTER OF DEEDS

Liber **00003** Page **0174**

Register of Deeds Stamp & File Number

4. Lot No. _____, Recorded Plat _____
5. Private Claims _____

I, EDWARD W. REED, in a field survey on JULY 18, 1997 do hereby state that under requirements of P.A. 74, Michigan P.A. of 1970, the corner points mentioned in lines 1 and 2 above were in conformance with regulations and rules therefore as required in the current manual of survey instructions of the United States Department of the Interior, Bureau of Land Management or by a decree of a Court of Law and /or that the corner points mentioned in lines 3, 4 and 5 above were in conformance with the rules of the Michigan Board of Land Surveyors or by a Decree of a Court of Law; established, re-established, monumented, recovered, found as expressed below:

A	B	C	D	E	F	G	H	I	J	K	L	M
	6	5	4	3	2	1						
	7	8	9	10	11	12						
	18	17	16	15	14	13						
	19	20	21	22	23	24						
	30	29	28	27	26	25						
	31	32	33	34	35	36						

NOTE: Not more than 2 corners, all in the same town and range, may be recorded on this certificate.

A. Description of original monument and accessories and/or subsequent restoration:
CORNER COMMON TO SECTIONS 22-23-26-27

- 1826: J. MULLETT, DEPT. SURVEYOR - CORNER SET
- 1879: J. BENNETT, DEPT. SURVEYOR - STONE SET FROM BEARING TREE
- 1988: D. MOSTROM, SURVEYOR - FOUND ROUNDED STONE 2" BELOW GRADE FROM ONE OLD WITNESS, SET 1/2" IRON BAR, RECORDED IN LCRC # II-0126

B. Description of corner evidence found and/or method applied in restoring or reestablishing corner:

FOUND 1/2" IRON WITH MOSTROM CAP

C. Description of monument for corner and accessories established to perpetuate locating the position of the corner:
SET REMON CAP ON IRON IN CI-MONUMENT BOX FLUSH WITH ROAD SURFACE


- CHAIN LINK FENCE POST, S72W 66.9'
- CHAIN LINK FENCE POST, S46W 86.0'
- C/L ROAD NORTH 1.0'
- POWER POLE, S5W 193.4'

ACCEPTED BY THE BRANCH COUNTY SURVEY PEER GROUP AS THE OFFICIAL CORNER UNDER MICHIGAN PUBLIC ACT 345 OF 1990 AT A MEETING HELD ON 7-10-97

E. Reed, Co. Rep.
E. REED, P. S.

AND IS ACCEPTED AS A CAREFUL AND FAITHFUL PERPETUATION OF THE POSITION OF THE ORIGINAL CORNER

Signed by Edward W. Reed Date JULY 18, 1997
EDWARD W. REED
Surveyor's Michigan License No. 33985

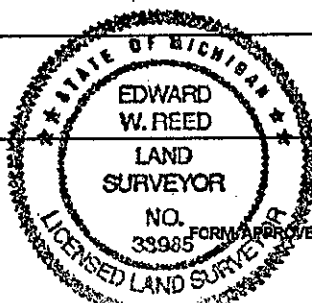

FORM APPROVED BY MICHIGAN STATE BOARD OF PROFESSIONAL SURVEYORS, JAN. 28
REVISED MAY 14, 1975