RE

FEB 2 2000

SECTION

# BRANCH COUNTY REMONUMENTATION CORNER
# LAND CORNER RECORDATION CERTIFICATE
**Filing Requirement of Act 74, Mich. P.A. 1970**

STATE OF MICHIGAN
Branch County
Recorded

12-30-1999 11:01:53

Linda Lee Morrison-Mathews
REGISTER OF DEEDS

Liber 00004 Page 0056

**Register of Deeds Stamp & File Number**

For corners In
BRANCH
(County)

SHERWOOD TOWNSHIP

| | | Located In: | Corner Code # |
|---|---|---|---|
| 1. Public Land Survey | | T 5S R 8W | K-1 |
| | | T___ R___ | |
| | | T___ R___ | |
| | | T___ R___ | |
| 2. Property Controlling | S___ | T___ R___ | |
| in Section | S___ | T___ R___ | |
| 3. Miscellaneous | S___ | T___ R___ | |
| Property in Sec. | S___ | T___ R___ | |

4. Lot No. _____ , Recorded Plat _____

5. Private Claims _____

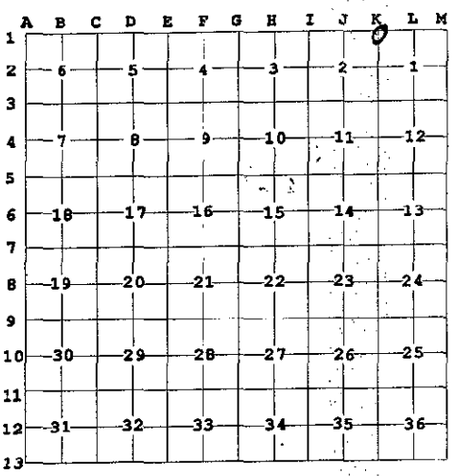


I, ROBERT R. CARR , in a field survey on NOVEMBER 3 , 19 99 do hereby state that under requirements of P.A. 74, Michigan P.A. of 1970, the corner points mentioned in lines 1 and 2 above were in conformance in regulations and rules therefore as required in the current manual of survey instructions of the United States Department of the Interior, Bureau of Land Management or by a decree of a Court of Law and /or that the corner points mentioned in lines 3, 4 and 5 above were in conformance with the rules of the Michigan Board of Land Surveyors or by a Decree of a Court of Law; established, re-established, monumented, recovered, found as expressed below:

**NOTE: Not more than 2 corners, all in the same town and range, may be recorded on this certificate.**

A. *Description of original monument and accessories and/or subsequent restoration:*

ORIGINAL CORNER SET BY JOHN MULLETT, D.S., 1826.
M. KNOWLES, COUNTY SURVEYOR, 1860, STONE 18, STAKE BELOW.
I.D. MINER, COUNTY SURVEYOR, 1891, FOUND PLOW POINT AND STONE.

B. Description of corner evidence found and/or method applied in restoring or reestablishing corner:

FOUND PLOW POINT, BRICK AND POTTERY 26.40 FEET EAST
OF CALHOUN COUNTY CORNER (HOLLOW CLAY TILE).
ACCEPTED AS BEST EVIDENCE OF ORIGINAL CORNER.
REPLACED PLOW POINT WITH BRANCH COUNTY REMONUMENTATION
IRON AND CAP IN MONUMENT BOX.

C. Description of monument for corner and accessories established to perpetuate locating the position of the corner:

BRANCH COUNTY REMONUMENTATION IRON AND CAP IN MONUMENT BOX
23 FEET EAST OF EAST EDGE OF GRAVEL ROAD
16" PINE N76°E 13.53 FEET, SET NAIL AND SPOTTER
R.R. RAIL POST, S72°E 2.91 FEET, SET NAIL AND SPOTTER
TWIN 18" ELM, S52°E 19.43 FEET, SET NAIL AND SPOTTER
14" POPLE, S10°W 52.11 FEET, SET NAIL AND SPOTTER
8" MAPLE, S66°W 53.11 FEET, SET NAIL AND SPOTTER

ACCEPTED BY THE BRANCH COUNTY SURVEY PEER GROUP AS THE OFFICIAL CORNER UNDER MICHIGAN PUBLIC ACT 345 OF 1990 AT A MEETING HELD ON DEC. 7, 1999
E. R. Reed, P.S.
E. R. REED

STATE OF MICHIGAN
ROBERT R. CARR
PROFESSIONAL SURVEYOR
No. 20704
LICENSED PROFESSIONAL SURVEYOR

Signed by _____ Date DEC 7, 1999

Surveyor's Michigan License No. 20704 ROBERT R. CARR

FORM APPROVED BY MICHIGAN STATE BOARD OF PROFESSIONAL SURVEYORS, JAN. 28, 1971
REVISED MAY 14,1975
REVISED JAN., 1983