

SURVEY & REMONUMENTATION

FEB 08 1999

SECTION

**BRANCH COUNTY REMONUMENTATION PROGRAM
LAND CORNER RECORDATION CERTIFICATE
Filing Requirement of Act 74, Mich. P.A. 1970**

Liber **00003** Page **0241**
STATE OF MICHIGAN
Branch County
Recorded

12-07-1998 13:52:34

Linda Lee Morrison-Mathews
REGISTER OF DEEDS

For corners in

<u>BRANCH COUNTY</u>	Located In:	Corner Code #
BUTLER TWP		
1. Public Land Survey	<u>T 5 S R 5 W</u>	<u>A-1</u>
	T ___ R ___	_____
	T ___ R ___	_____
	T ___ R ___	_____
2. Property Controlling in Section	S ___ T ___ R ___	_____
	S ___	_____
	T ___ R ___	_____
3. Miscellaneous	S ___	_____
	T ___ R ___	_____
Property in Sec.	S ___	_____
	T ___ R ___	_____

ACCEPTED TO THE BRANCH COUNTY SURVEY PEER GROUP AS THE OFFICIAL CORNER UNDER MICHIGAN PUBLIC ACT 845 OF 1990 AT A MEETING HELD ON 11-24-1998

E.R. Reed Co. Rep.
E.R. REED

4. Lot No. _____, Recorded Plat _____
5. Private Claims _____

I, EDWARD W. REED, in a field survey on JULY 14, 1998 do hereby state that under requirements of P.A. 74, Michigan P.A. of 1970, the corner points mentioned in lines 1 and 2 above were in conformance with regulations and rules therefore as required in the current manual of survey instructions of the United States Department of the Interior, Bureau of Land Management or by a decree of a Court of Law and /or that the corner points mentioned in lines 3, 4 and 5 above were in conformance with the rules of the Michigan Board of Land Surveyors or by a Decree of a Court of Law; established, re-established, monumented, recovered, found as expressed below:

NOTE: Not more than 2 corners, all in the same town and range, may be recorded on this certificate.

CORNER COMMON TO SECTION 6, BUTLER TWP., BRANCH COUNTY,
SECTION 1, GIRARD TWP., BRANCH COUNTY
SECTION 36, TEKONSHA TWP., CALHOUN COUNTY
SECTION 31, CLARENDON TWP., CALHOUN COUNTY

	B	C	D	E	F	G	H	I	J	K	L	M
2	6	5	4	3	2	1						
3												
4	7	8	9	10	11	12						
5												
6	18	17	16	15	14	13						
7												
8	19	20	21	22	23	24						
9												
10	30	29	28	27	26	25						
11												
12	31	32	33	34	35	36						
13												

A. Description of original monument and accessories and/or subsequent restoration:

1825: WM. BROOKFIELD, DEPT. SURVEYOR - CORNER SET
1907: CHAS. HAMILTON, CO SURVEYOR - FOUND DRAIN TILE FILLED WITH COAL UNDER BIG STONE
1977: E .R. REED, CO SURVEYOR - FOUND TILE FILLED WITH COAL, IRON "KETTLE", BROKEN GREEN GLASS, & BROKEN BRICK, BUT NO STONE, RECORDED IN LCRC # 198, SET 3/4" IRON ROD WITH RLS CAP THRU IRON & TILE


B. Description of corner evidence found and/or method applied in restoring or reestablishing corner:

FOUND 3/4" X 18 CAPPED IRON WITH GLASS, BRICK AND TILE

C. Description of monument for corner and accessories established to perpetuate locating the position of the corner:

SET 1/2" X 18" REBAR IRON WITH REMON CAP IN CI-MONUMENT BOX 4" BELOW GRAVEL ROAD SURFACE
TEL PED N 76 E 87.7'
2" CEDAR S 11 E 102.5'
22" CHERRY TREE S 65 E 85.8' TO CENTER
2" X 2" ANGLE IRON POST N 27 E 30.7' TO FACE
ROAD NAME SIGN S 29 E 41.6' TO FACE

AND IS ACCEPTED AS A CAREFUL AND FAITHFUL PERPETUATION OF THE POSITION OF THE ORIGINAL CORNER.

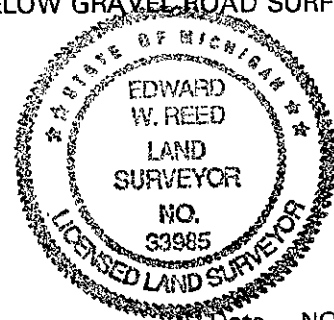

Signed by Edward W. Reed Date NOV. 4, 1998

EDWARD W, REED

Surveyor's Michigan License No. 33985