

SURVEY & REMONUMENTATION

FEB 08 1999

SECTION

BRANCH COUNTY REMONUMENTATION PROGRAM
LAND CORNER RECORDATION CERTIFICATE
Filing Requirement of Act 74, Mich. P.A. 1970

31115

For corners in

BRANCH COUNTY
BUTLER TWP

Located In:

Corner Code #

1. Public Land Survey

T 5 S R 5 W

A-2

T R

T R

T R

2. Property Controlling in Section

S T R

S

T R

3. Miscellaneous

S

T R

Property in Sec.

S

T R

STATE OF MICHIGAN
Branch County
Recorded

11-04-1998 15:45:20

Linda Lee Morrison-Mathews
REGISTER OF DEEDS

Register of Deeds Stamp & File Number

ACCEPTED BY THE BRANCH COUNTY
SURVEY PEER GROUP AS THE OFFICIAL
CORNER UNDER MICHIGAN PUBLIC ACT 345
OF 1970 AT MEETING HELD ON

Sept. 09 1998
E. R. Reed Co. Rep.
E. R. REED.

4. Lot No. _____, Recorded Plat _____
5. Private Claims _____

I, EDWARD W. REED, in a field survey on AUGUST 28, 1998 do hereby state that under requirements of P.A. 74, Michigan P.A. of 1970, the corner points mentioned in lines 1 and 2 above were in conformance with regulations and rules therefore as required in the current manual of survey instructions of the United States Department of the Interior, Bureau of Land Management or by a decree of a Court of Law and/or that the corner points mentioned in lines 3, 4 and 5 above were in conformance with the rules of the Michigan Board of Land Surveyors or by a Decree of a Court of Law; established, re-established, monumented, recovered, found as expressed below:

NOTE: Not more than 2 corners, all in the same town and range, may be recorded on this certificate.

WEST QUARTER CORNER SECTION 6

A. Description of original monument and accessories and/or subsequent restoration:

1907: CHAS. HAMILTON, CO SURVEYOR - WAGON HUB WITH TIP PAN ON TOP & STAKE DRIVEN THROUGH PAN & HUB
1977: E.R. REED, CO SURVEYOR - FOUND PAN & WAGON HUB WITH STONES, SET 1/2" X 18" REBAR IRON & CAP THRU HUB CENTER, RECORDED IN LCRC # 0198

B. Description of corner evidence found and/or method applied in restoring or reestablishing corner:


FOUND WAGON HUB & STONES & 1/2" CAPPED IRON THRU HUB CENTER, FITTING WITNESS OF LCRC # 0198

C. Description of monument for corner and accessories established to perpetuate locating the position of the corner:

SET CI-MONUMENT BOX OVER IRON, PLACE REMON CAP ON EXISTING IRON, SET MONUMENT BOX 4" BELOW GRAVEL ROAD SURFACE

22" ASH S 32 W 26.8' TO CENTER
10" TWIN OAK S 80 W 16.0' TO CENTER
20" SHAG HICKORY N 23 W 52.2' TO CENTER
NW CORNER OF EAST BRIDGE HEADWALL S 02 E 189.1'
8' WEST OF C/L OF N-S GRAVEL ROAD

	A	B	C	D	E	F	G	H	I	J	K	L	M
1	6	5	4	3	2	1							
3													
4	7	8	9	10	11	12							
5													
6	18	17	16	15	14	13							
7													
8	19	20	21	22	23	24							
9													
10	30	29	28	27	26	25							
11													
12	31	32	33	34	35	36							
13													

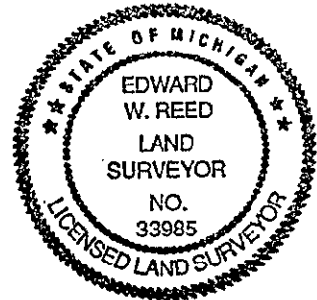

AND IS ACCEPTED AS A CAREFUL AND FAITHFUL PERPETUATION OF THE POSITION OF THE ORIGINAL CORNER.

Signed by Edward W. Reed
EDWARD W. REED

Surveyor's Michigan License No. 33985

Date SEPTEMBER 9, 1998
Liber 000003 Page 0204 A